



SECTION E-E


DETAIL "7" (SEE DWG 1565-100)

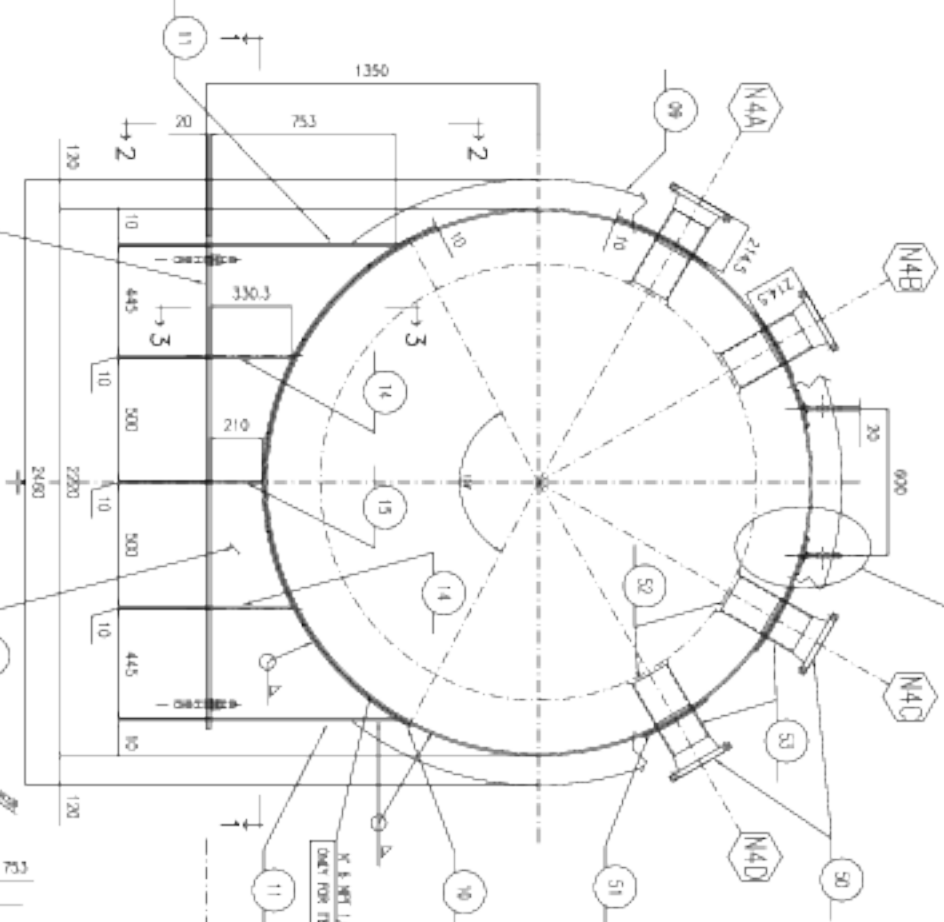

SECTION 2-2

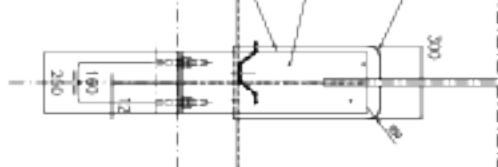


SECTION 3-3

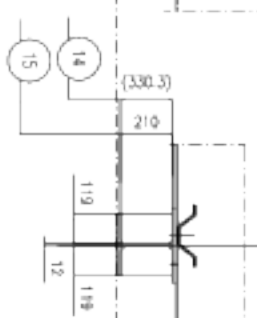


SECTION F-F


DETAIL "7" (SEE DWG 1565-100)

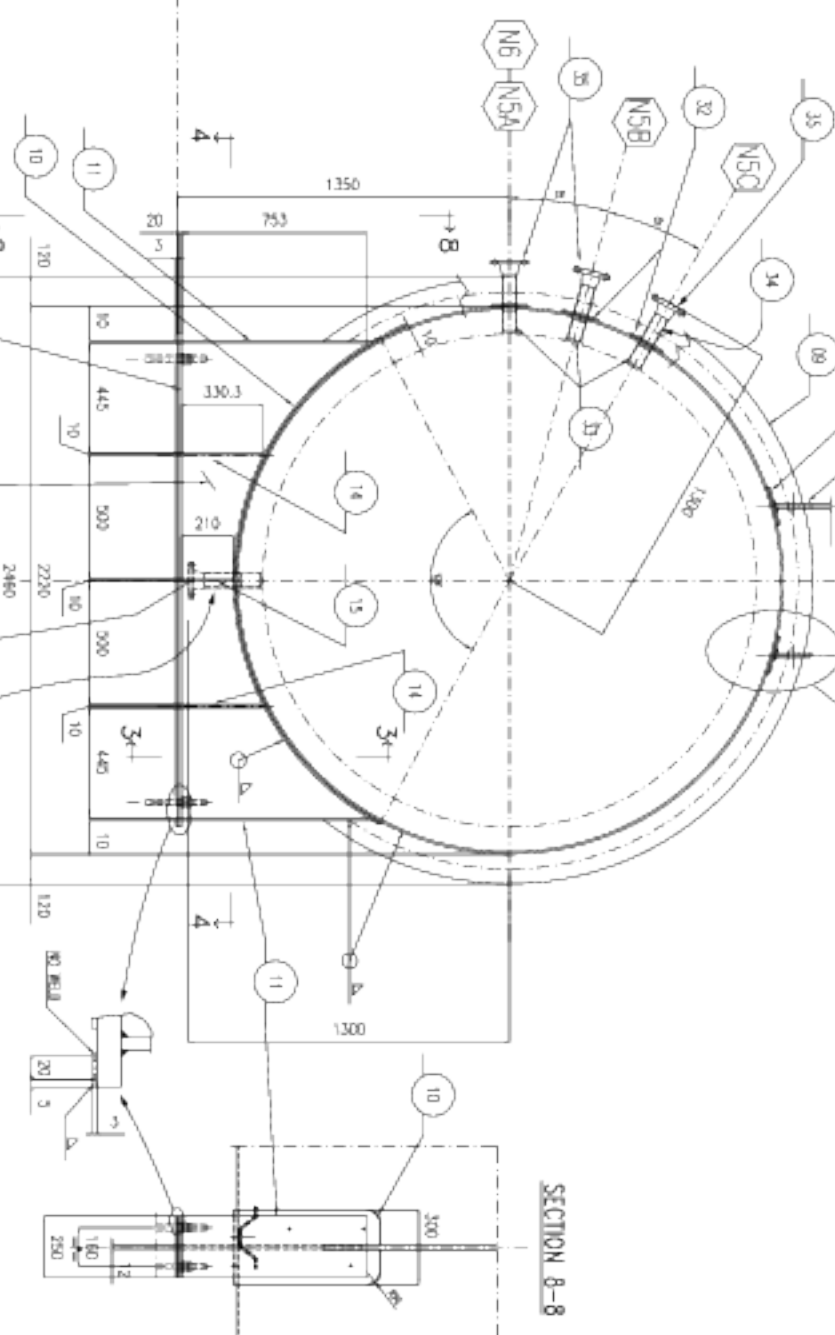


SECTION 8-8

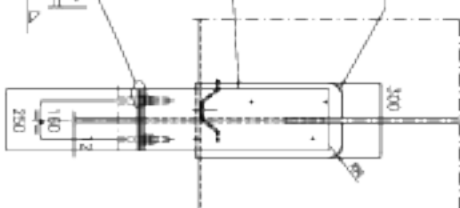

NOZZLE N4A/B/C/D DETAIL

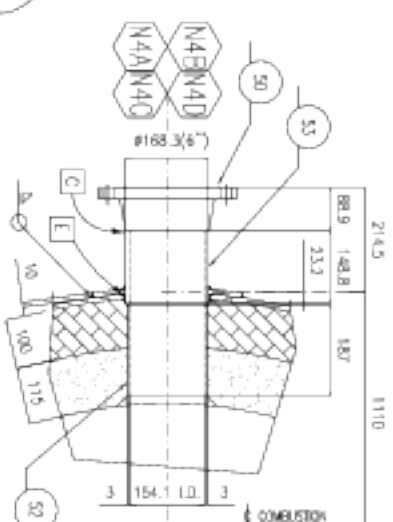


SECTION 4-4

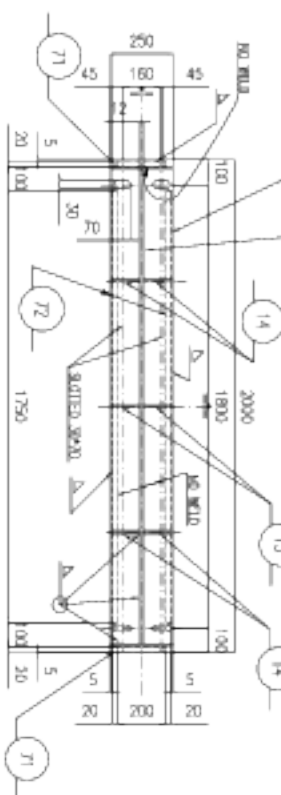


DETAIL "6"


SIGHT PORT DETAIL

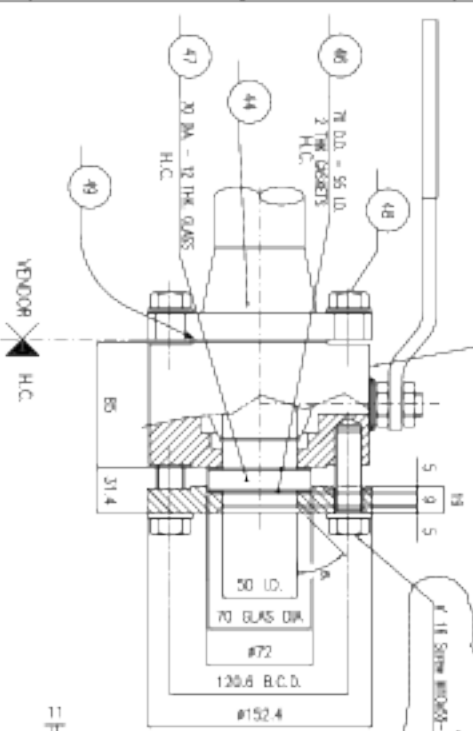


NOZZLE N2A/B DETAIL

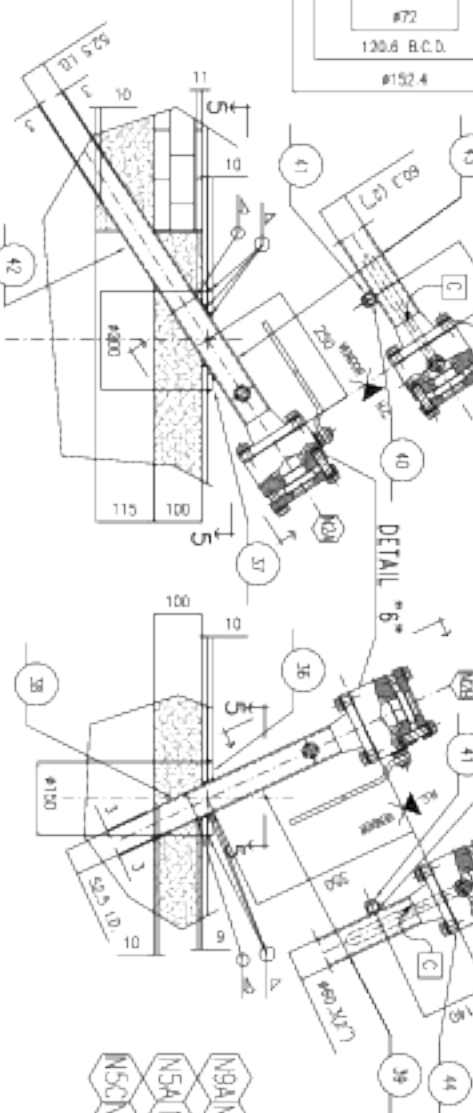

NOZZLE N5A/B/C-N6-N9A/B DETAIL

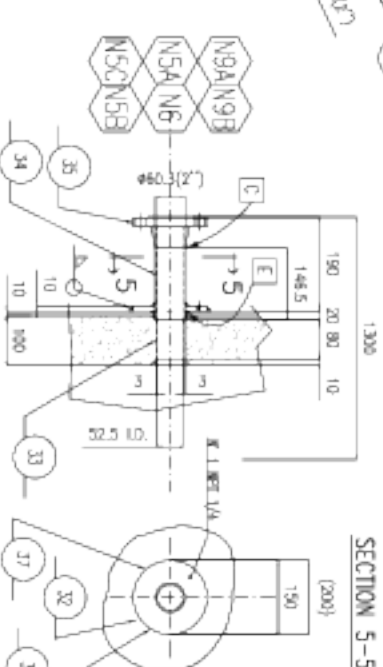

SECTION 5-5

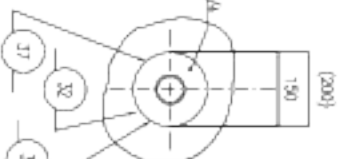

TYPICAL WELDED		TYPICAL	
1. 1/2" 304	2. 1/2" 304	3. 1/2" 304	4. 1/2" 304
5. 1/2" 304	6. 1/2" 304	7. 1/2" 304	8. 1/2" 304
9. 1/2" 304	10. 1/2" 304	11. 1/2" 304	12. 1/2" 304
13. 1/2" 304	14. 1/2" 304	15. 1/2" 304	16. 1/2" 304
17. 1/2" 304	18. 1/2" 304	19. 1/2" 304	20. 1/2" 304
21. 1/2" 304	22. 1/2" 304	23. 1/2" 304	24. 1/2" 304
25. 1/2" 304	26. 1/2" 304	27. 1/2" 304	28. 1/2" 304
29. 1/2" 304	30. 1/2" 304	31. 1/2" 304	32. 1/2" 304
33. 1/2" 304	34. 1/2" 304	35. 1/2" 304	36. 1/2" 304
37. 1/2" 304	38. 1/2" 304	39. 1/2" 304	40. 1/2" 304
41. 1/2" 304	42. 1/2" 304	43. 1/2" 304	44. 1/2" 304
45. 1/2" 304	46. 1/2" 304	47. 1/2" 304	48. 1/2" 304
49. 1/2" 304	50. 1/2" 304	51. 1/2" 304	52. 1/2" 304
53. 1/2" 304	54. 1/2" 304	55. 1/2" 304	56. 1/2" 304
57. 1/2" 304	58. 1/2" 304	59. 1/2" 304	60. 1/2" 304
61. 1/2" 304	62. 1/2" 304	63. 1/2" 304	64. 1/2" 304
65. 1/2" 304	66. 1/2" 304	67. 1/2" 304	68. 1/2" 304
69. 1/2" 304	70. 1/2" 304	71. 1/2" 304	72. 1/2" 304
73. 1/2" 304	74. 1/2" 304	75. 1/2" 304	76. 1/2" 304
77. 1/2" 304	78. 1/2" 304	79. 1/2" 304	80. 1/2" 304
81. 1/2" 304	82. 1/2" 304	83. 1/2" 304	84. 1/2" 304
85. 1/2" 304	86. 1/2" 304	87. 1/2" 304	88. 1/2" 304
89. 1/2" 304	90. 1/2" 304	91. 1/2" 304	92. 1/2" 304
93. 1/2" 304	94. 1/2" 304	95. 1/2" 304	96. 1/2" 304
97. 1/2" 304	98. 1/2" 304	99. 1/2" 304	100. 1/2" 304

FOR ASSEMBLY SEE DWG 165-102

REVISIONS		REVISIONS	
1. 1/2" 304	2. 1/2" 304	3. 1/2" 304	4. 1/2" 304
5. 1/2" 304	6. 1/2" 304	7. 1/2" 304	8. 1/2" 304
9. 1/2" 304	10. 1/2" 304	11. 1/2" 304	12. 1/2" 304
13. 1/2" 304	14. 1/2" 304	15. 1/2" 304	16. 1/2" 304
17. 1/2" 304	18. 1/2" 304	19. 1/2" 304	20. 1/2" 304
21. 1/2" 304	22. 1/2" 304	23. 1/2" 304	24. 1/2" 304
25. 1/2" 304	26. 1/2" 304	27. 1/2" 304	28. 1/2" 304
29. 1/2" 304	30. 1/2" 304	31. 1/2" 304	32. 1/2" 304
33. 1/2" 304	34. 1/2" 304	35. 1/2" 304	36. 1/2" 304
37. 1/2" 304	38. 1/2" 304	39. 1/2" 304	40. 1/2" 304
41. 1/2" 304	42. 1/2" 304	43. 1/2" 304	44. 1/2" 304
45. 1/2" 304	46. 1/2" 304	47. 1/2" 304	48. 1/2" 304
49. 1/2" 304	50. 1/2" 304	51. 1/2" 304	52. 1/2" 304
53. 1/2" 304	54. 1/2" 304	55. 1/2" 304	56. 1/2" 304
57. 1/2" 304	58. 1/2" 304	59. 1/2" 304	60. 1/2" 304
61. 1/2" 304	62. 1/2" 304	63. 1/2" 304	64. 1/2" 304
65. 1/2" 304	66. 1/2" 304	67. 1/2" 304	68. 1/2" 304
69. 1/2" 304	70. 1/2" 304	71. 1/2" 304	72. 1/2" 304
73. 1/2" 304	74. 1/2" 304	75. 1/2" 304	76. 1/2" 304
77. 1/2" 304	78. 1/2" 304	79. 1/2" 304	80. 1/2" 304
81. 1/2" 304	82. 1/2" 304	83. 1/2" 304	84. 1/2" 304
85. 1/2" 304	86. 1/2" 304	87. 1/2" 304	88. 1/2" 304
89. 1/2" 304	90. 1/2" 304	91. 1/2" 304	92. 1/2" 304
93. 1/2" 304	94. 1/2" 304	95. 1/2" 304	96. 1/2" 304
97. 1/2" 304	98. 1/2" 304	99. 1/2" 304	100. 1/2" 304