
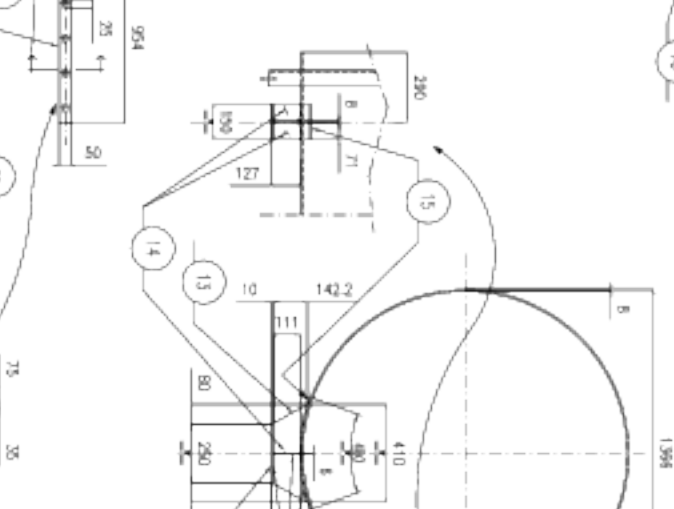
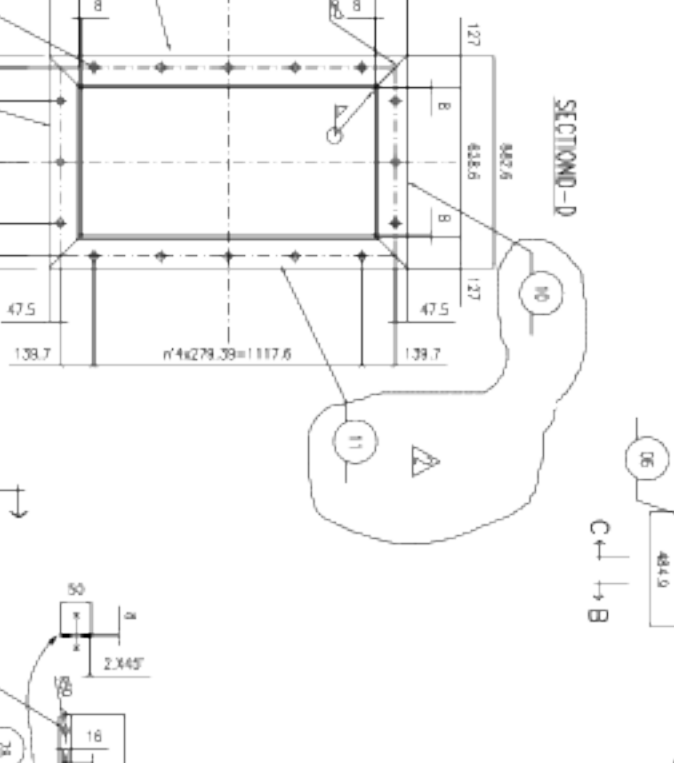





LIST OF BOLTS

ITEM	DESCRIPTION	QTY	UNIT	REMARKS
1	1/2" DIA. X 6" LONG	10	PCS	
2	1/2" DIA. X 4" LONG	20	PCS	
3	1/2" DIA. X 3" LONG	10	PCS	
4	1/2" DIA. X 2" LONG	10	PCS	
5	1/2" DIA. X 1" LONG	10	PCS	
6	1/2" DIA. X 1/2" LONG	10	PCS	
7	1/2" DIA. X 3/4" LONG	10	PCS	
8	1/2" DIA. X 5/8" LONG	10	PCS	
9	1/2" DIA. X 7/8" LONG	10	PCS	
10	1/2" DIA. X 1" LONG	10	PCS	
11	1/2" DIA. X 1 1/4" LONG	10	PCS	
12	1/2" DIA. X 1 1/2" LONG	10	PCS	
13	1/2" DIA. X 1 3/4" LONG	10	PCS	
14	1/2" DIA. X 2" LONG	10	PCS	
15	1/2" DIA. X 2 1/4" LONG	10	PCS	
16	1/2" DIA. X 2 1/2" LONG	10	PCS	
17	1/2" DIA. X 2 3/4" LONG	10	PCS	
18	1/2" DIA. X 3" LONG	10	PCS	
19	1/2" DIA. X 3 1/4" LONG	10	PCS	
20	1/2" DIA. X 3 1/2" LONG	10	PCS	
21	1/2" DIA. X 3 3/4" LONG	10	PCS	
22	1/2" DIA. X 4" LONG	10	PCS	
23	1/2" DIA. X 4 1/4" LONG	10	PCS	
24	1/2" DIA. X 4 1/2" LONG	10	PCS	
25	1/2" DIA. X 4 3/4" LONG	10	PCS	
26	1/2" DIA. X 5" LONG	10	PCS	
27	1/2" DIA. X 5 1/4" LONG	10	PCS	
28	1/2" DIA. X 5 1/2" LONG	10	PCS	
29	1/2" DIA. X 5 3/4" LONG	10	PCS	
30	1/2" DIA. X 6" LONG	10	PCS	

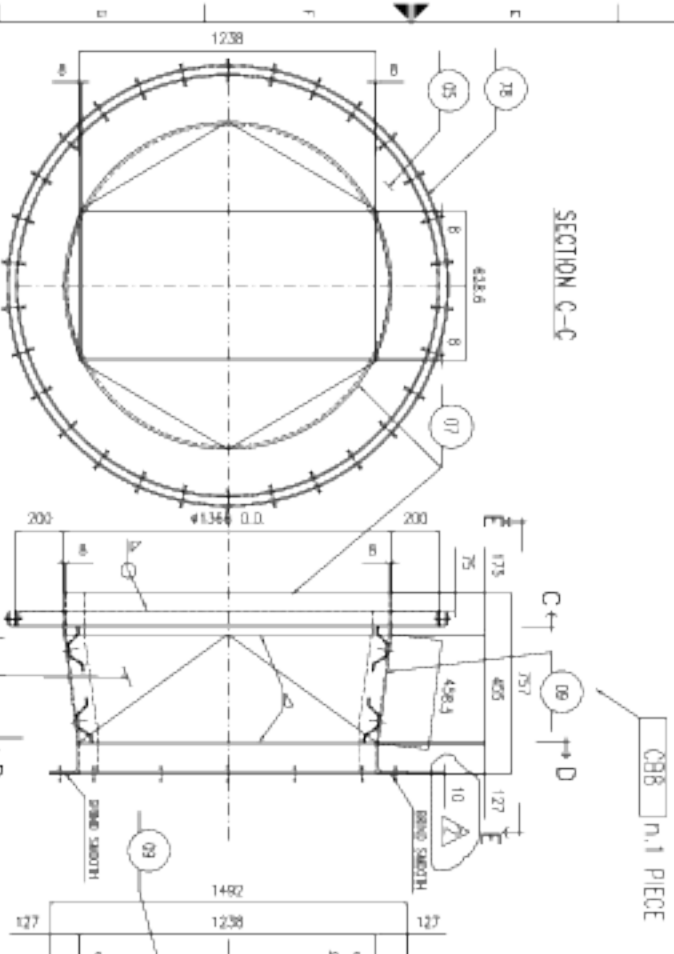

LIST OF BOLTS

ITEM	DESCRIPTION	QTY	UNIT	REMARKS
31	1/2" DIA. X 6" LONG	10	PCS	
32	1/2" DIA. X 4" LONG	20	PCS	
33	1/2" DIA. X 3" LONG	10	PCS	
34	1/2" DIA. X 2" LONG	10	PCS	
35	1/2" DIA. X 1" LONG	10	PCS	
36	1/2" DIA. X 1/2" LONG	10	PCS	
37	1/2" DIA. X 3/4" LONG	10	PCS	
38	1/2" DIA. X 5/8" LONG	10	PCS	
39	1/2" DIA. X 7/8" LONG	10	PCS	
40	1/2" DIA. X 1" LONG	10	PCS	
41	1/2" DIA. X 1 1/4" LONG	10	PCS	
42	1/2" DIA. X 1 1/2" LONG	10	PCS	
43	1/2" DIA. X 1 3/4" LONG	10	PCS	
44	1/2" DIA. X 2" LONG	10	PCS	
45	1/2" DIA. X 2 1/4" LONG	10	PCS	
46	1/2" DIA. X 2 1/2" LONG	10	PCS	
47	1/2" DIA. X 2 3/4" LONG	10	PCS	
48	1/2" DIA. X 3" LONG	10	PCS	
49	1/2" DIA. X 3 1/4" LONG	10	PCS	
50	1/2" DIA. X 3 1/2" LONG	10	PCS	
51	1/2" DIA. X 3 3/4" LONG	10	PCS	
52	1/2" DIA. X 4" LONG	10	PCS	
53	1/2" DIA. X 4 1/4" LONG	10	PCS	
54	1/2" DIA. X 4 1/2" LONG	10	PCS	
55	1/2" DIA. X 4 3/4" LONG	10	PCS	
56	1/2" DIA. X 5" LONG	10	PCS	
57	1/2" DIA. X 5 1/4" LONG	10	PCS	
58	1/2" DIA. X 5 1/2" LONG	10	PCS	
59	1/2" DIA. X 5 3/4" LONG	10	PCS	
60	1/2" DIA. X 6" LONG	10	PCS	

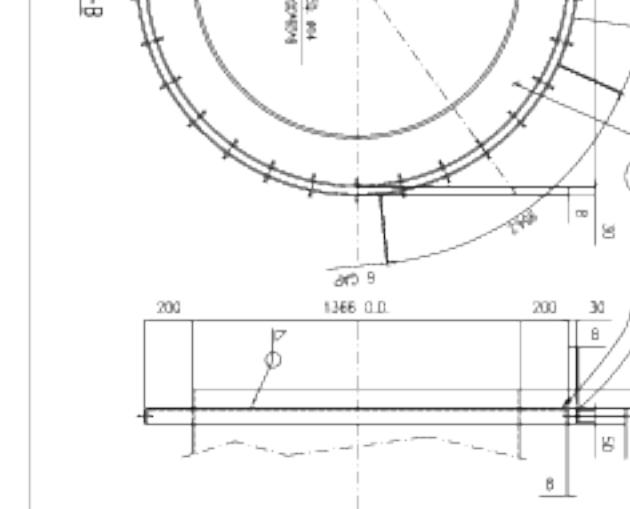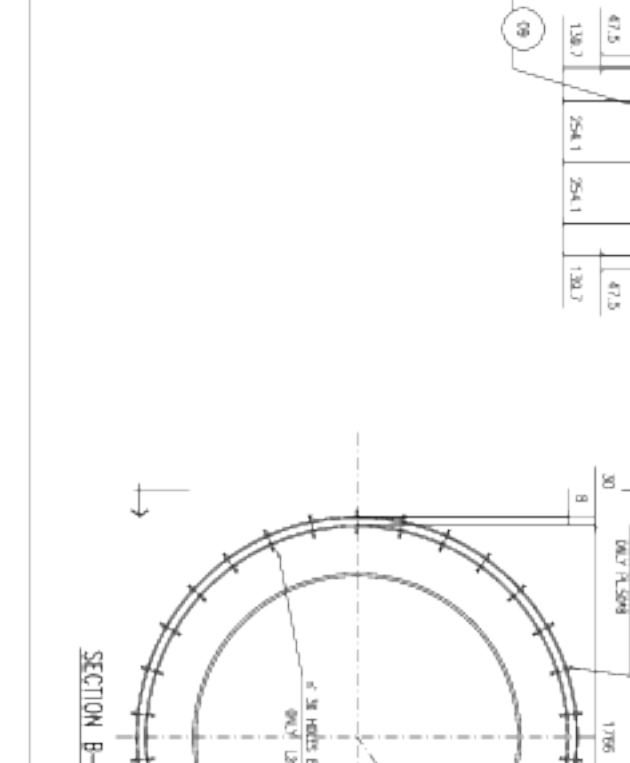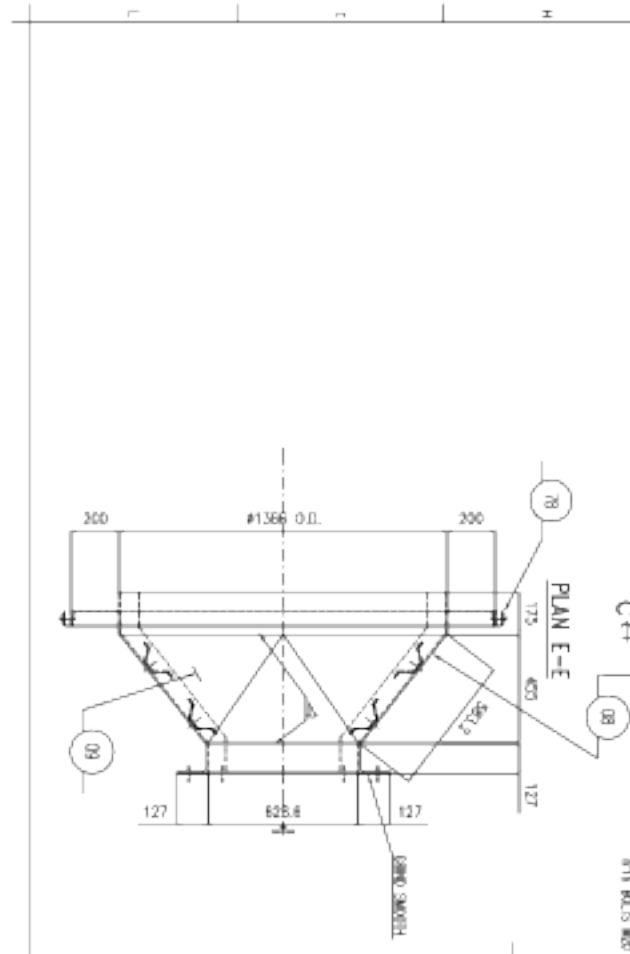

LIST OF BOLTS

ITEM	DESCRIPTION	QTY	UNIT	REMARKS
61	1/2" DIA. X 6" LONG	10	PCS	
62	1/2" DIA. X 4" LONG	20	PCS	
63	1/2" DIA. X 3" LONG	10	PCS	
64	1/2" DIA. X 2" LONG	10	PCS	
65	1/2" DIA. X 1" LONG	10	PCS	
66	1/2" DIA. X 1/2" LONG	10	PCS	
67	1/2" DIA. X 3/4" LONG	10	PCS	
68	1/2" DIA. X 5/8" LONG	10	PCS	
69	1/2" DIA. X 7/8" LONG	10	PCS	
70	1/2" DIA. X 1" LONG	10	PCS	
71	1/2" DIA. X 1 1/4" LONG	10	PCS	
72	1/2" DIA. X 1 1/2" LONG	10	PCS	
73	1/2" DIA. X 1 3/4" LONG	10	PCS	
74	1/2" DIA. X 2" LONG	10	PCS	
75	1/2" DIA. X 2 1/4" LONG	10	PCS	
76	1/2" DIA. X 2 1/2" LONG	10	PCS	
77	1/2" DIA. X 2 3/4" LONG	10	PCS	
78	1/2" DIA. X 3" LONG	10	PCS	
79	1/2" DIA. X 3 1/4" LONG	10	PCS	
80	1/2" DIA. X 3 1/2" LONG	10	PCS	
81	1/2" DIA. X 3 3/4" LONG	10	PCS	
82	1/2" DIA. X 4" LONG	10	PCS	
83	1/2" DIA. X 4 1/4" LONG	10	PCS	
84	1/2" DIA. X 4 1/2" LONG	10	PCS	
85	1/2" DIA. X 4 3/4" LONG	10	PCS	
86	1/2" DIA. X 5" LONG	10	PCS	
87	1/2" DIA. X 5 1/4" LONG	10	PCS	
88	1/2" DIA. X 5 1/2" LONG	10	PCS	
89	1/2" DIA. X 5 3/4" LONG	10	PCS	
90	1/2" DIA. X 6" LONG	10	PCS	