


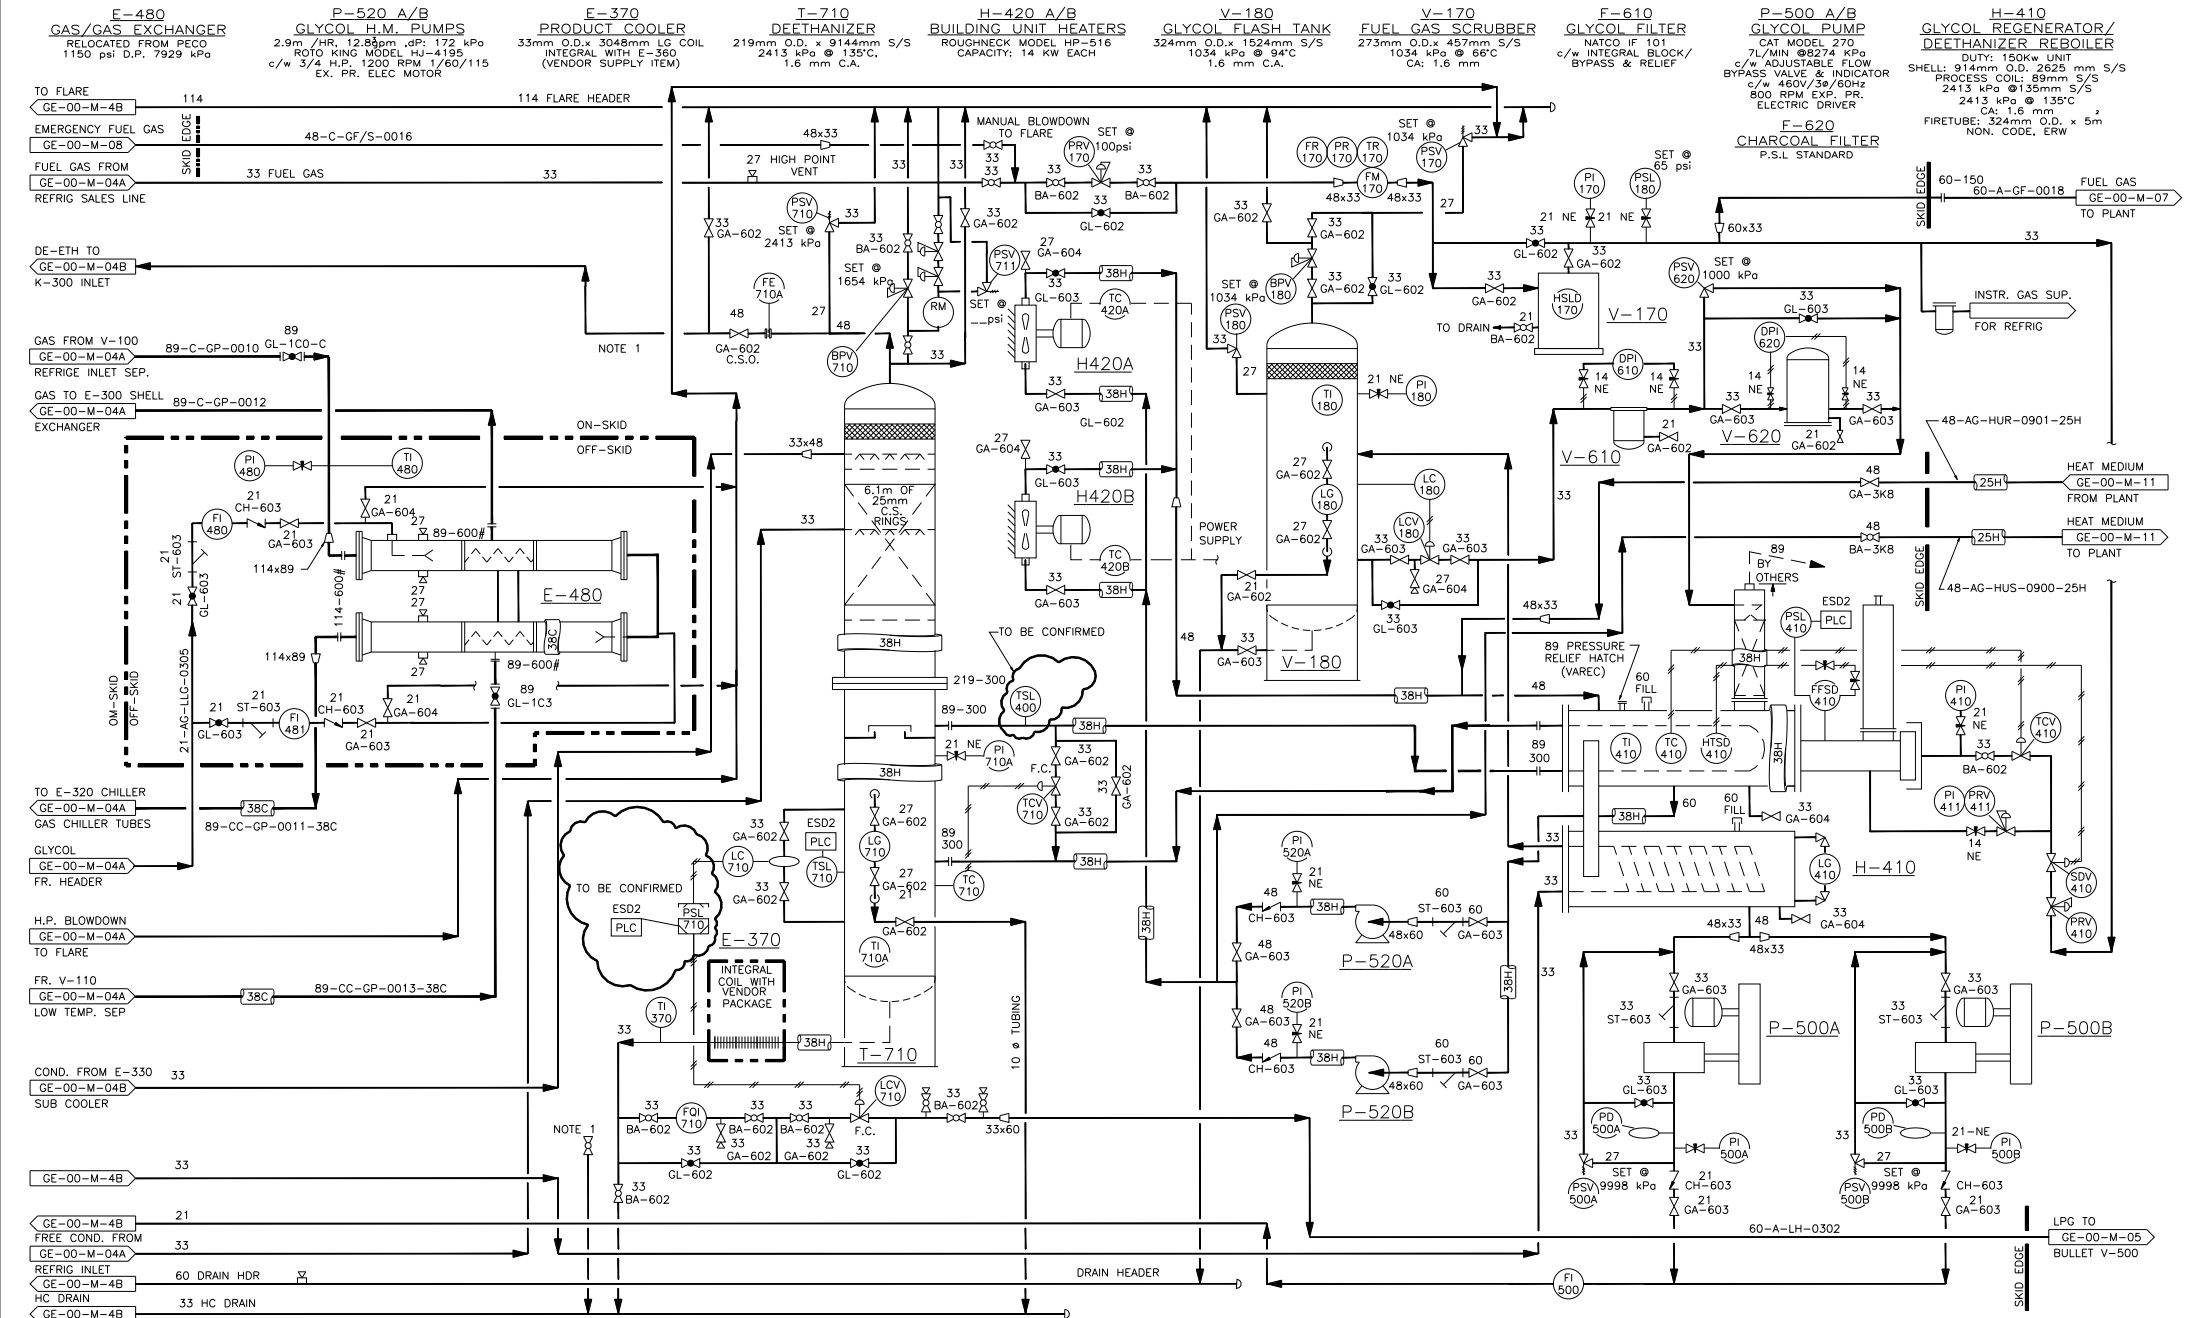


NOTES: 1. ORIGINAL OVERHEADS COMPRESSOR REMOVED FROM SKID.

1810
PROJ: P-5000

NUMBER	REFERENCE DRAWINGS	NO	REVISION DESCRIPTION	BY	DATE	CHD	APPD
E-MFS-85348100 SH 3of3	PROPAK Ltd	O	REDRAWN ON AutoCAD	J.W.	98.12.20	LJC	D.M.
		A	ISSUED FOR APPROVAL	CDC	99.01.11	D.M.	D.M.
		B	ISSUED FOR CONSTRUCTION	CDC	99.01.21	D.M.	D.M.
		C	AS PER CUSTOMER REQUEST	LJC	99.02.08	LJC	D.M.
		D	AS PER CUSTOMER REQUEST	CR	99.02.09	D.M.	D.M.
		E	AS BUILT (AS PER ENGINEER)	CDC	99.03.15	D.M.	D.M.

ENGINEERS & PERMIT STAMPS

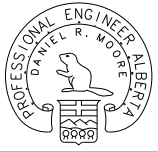

PERMIT TO PRACTICE

Tundra Engineering Ltd.

Signature _____

Date _____

PERMIT NUMBER: P-5951

The Association of Professional Engineers,
Geologists and geophysicists of Alberta

Tundra

TUNDRA ENGINEERING LTD.
CALGARY, ALBERTA



RIO ALTO EXPLORATION LTD.
A1-GE-00-M-04C
GEORGE
6-32-82-5-W6M
REFRIGERATION PLANT
MECHANICAL FLOW DIAGRAM

BY	DRAWN	CHECKED	APPROVED	SCALE	DRAWING NUMBER	REV
DATE	J. Wiecheci	L. Corbett	D. Moore	N.T.S.	D-GE00632-320-08	E
	98.12.20	98.12.20	98.12.22			