


P:\30000 Projects\31979-02 Devon Canada - Ferrer - 03606E.dwg - Ferrer - 03606E.dwg - Sales Coe V. Drafting\31979-02-MODEL (AS BUILT).dwg

PLOT DATE Feb 07, 2014, hsun

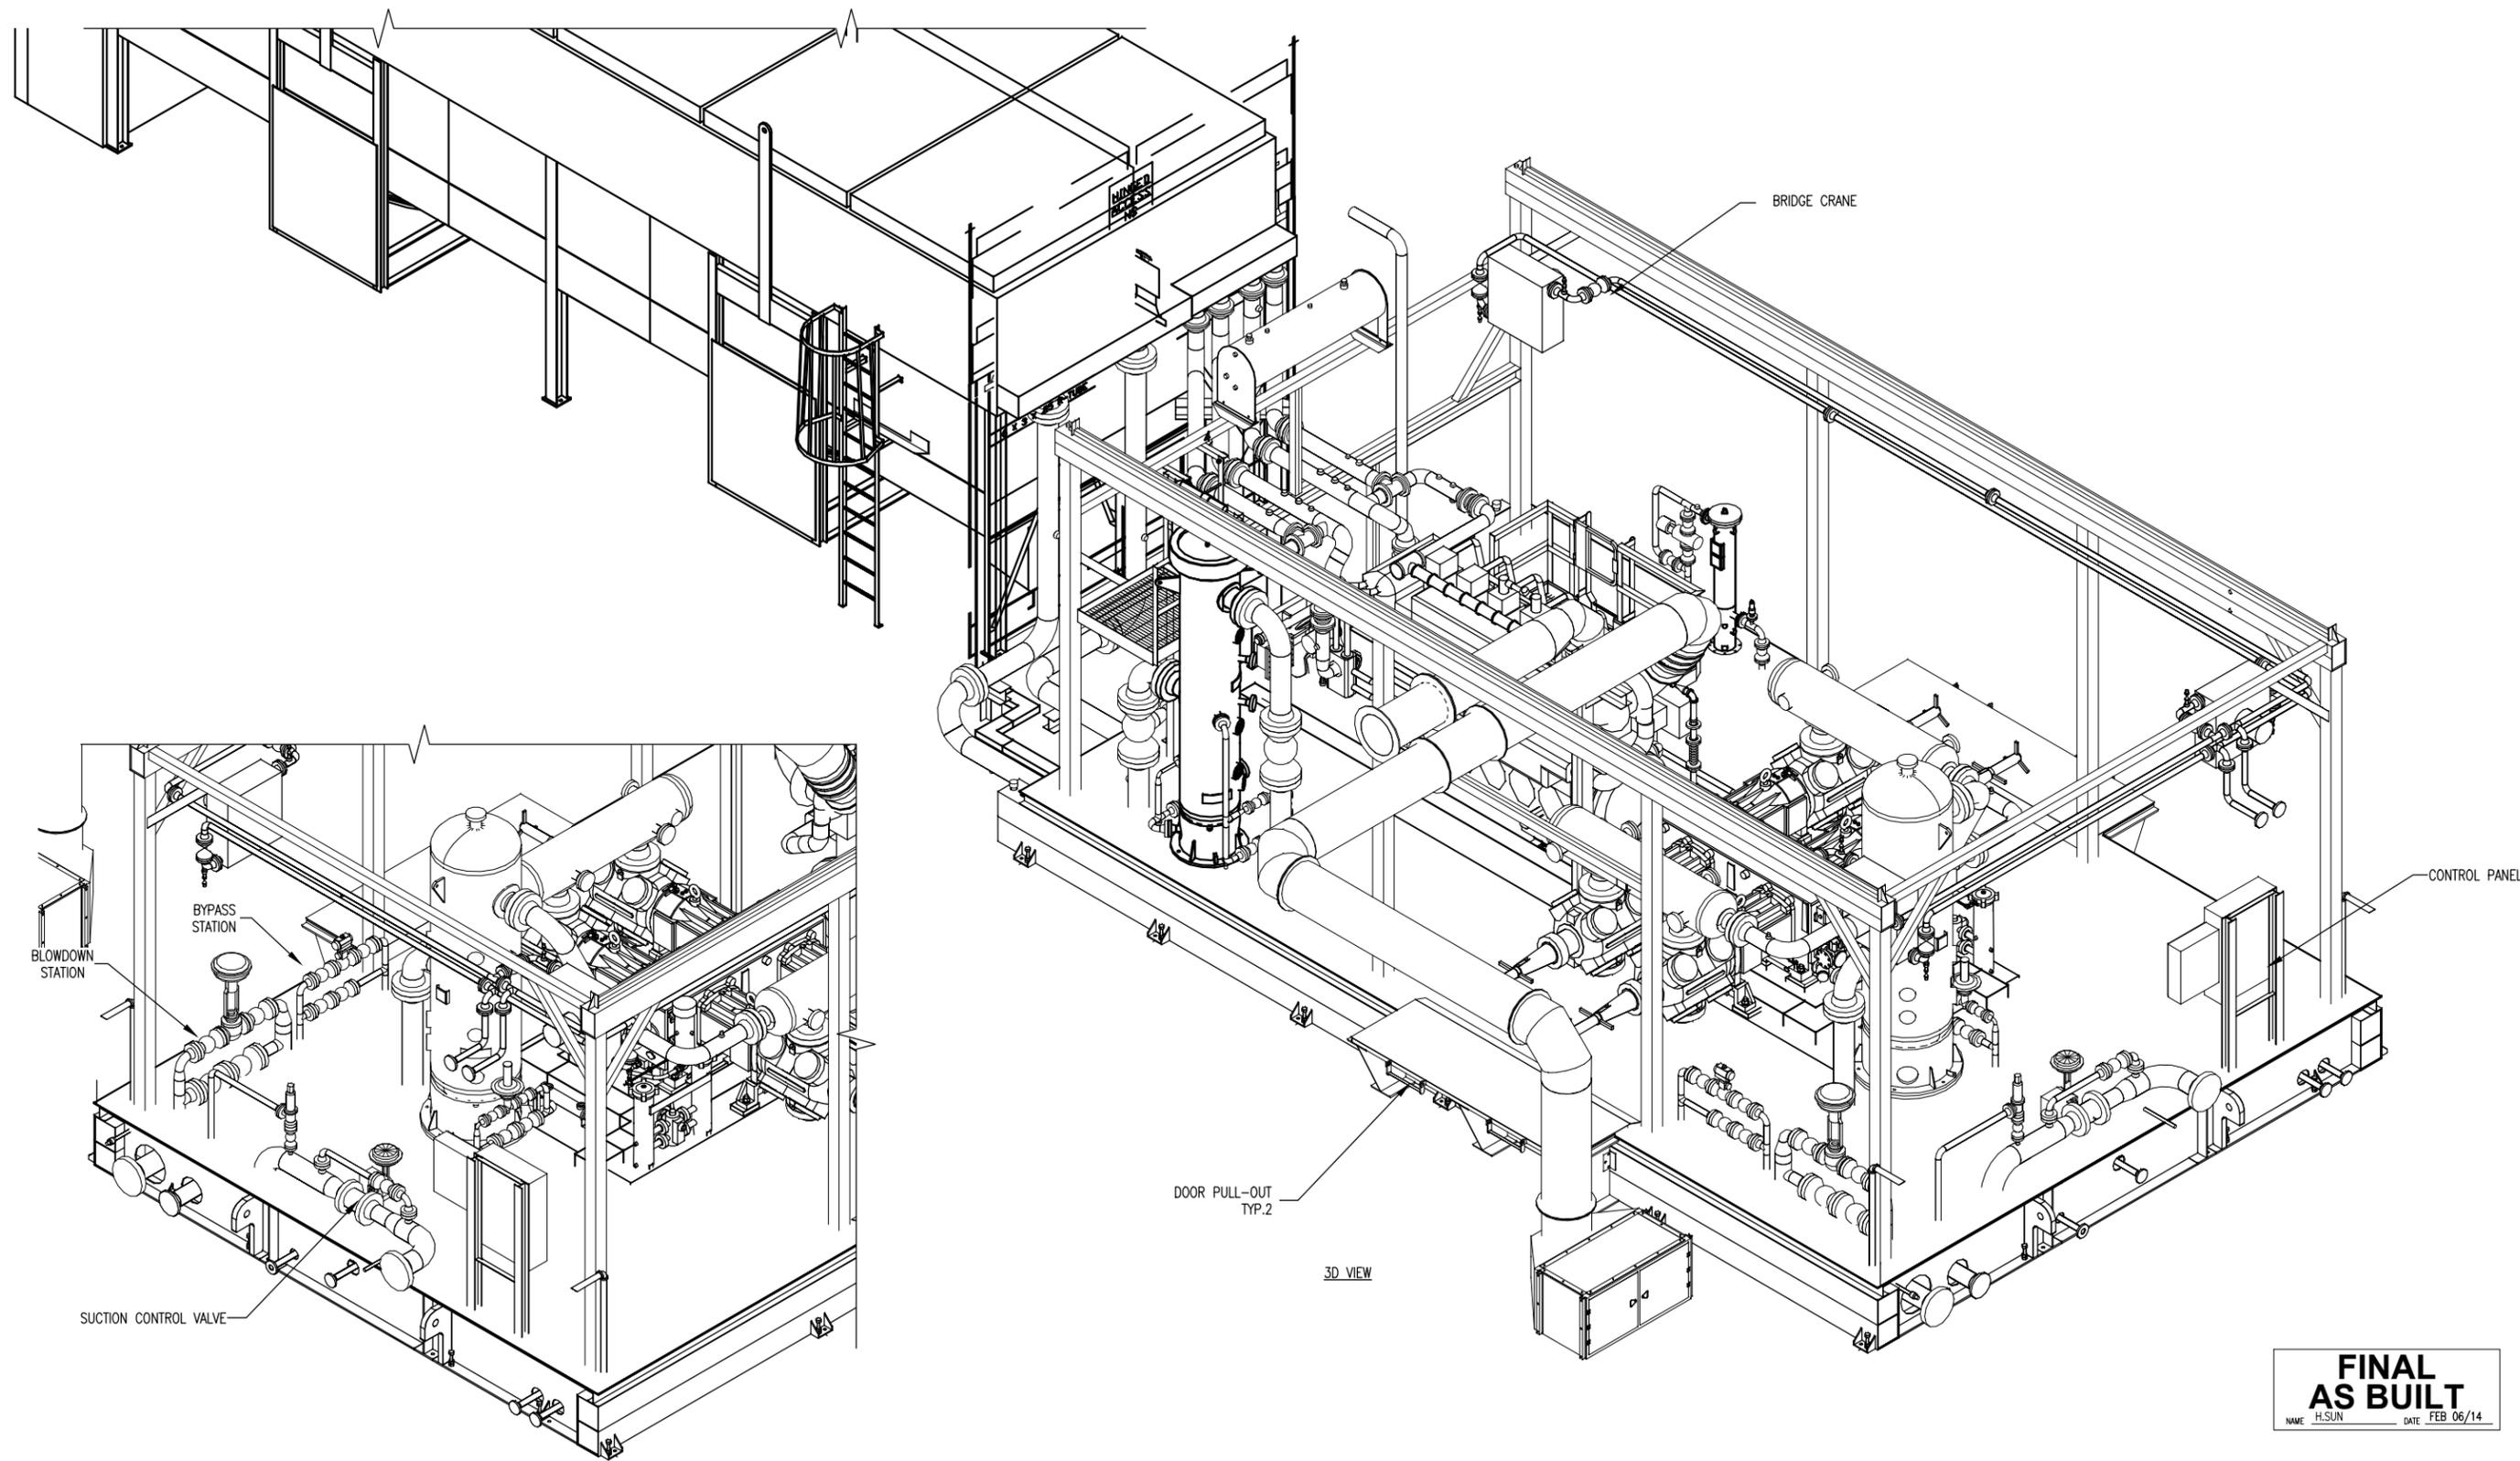

FINAL AS BUILT
 NAME H.SUN DATE FEB 06/14

4	REVISED & AS BUILT	FEB/06/14	HS	SG	DATE FEB 1/13	SCALE 3/8"=1'-0"	DEVON CANADA	ENERFLEX Calgary, Alberta, Canada	GENERAL ARRANGEMENT 3D VIEW	DWG NO 31979-02-201	SHT 5	REV 4
3	AS BUILT	SEP/03/13	HS	SG	DRAWN BY C.EASTHOPE	CHECKED BY G.TIWANA	APPROVED BY S.GURI					
2	REV'D WEIGHTS & NOZZLE SCHEDULE	MAY/23/13	CE	SG	PROJECT MANAGER B.MINSHULL	PROJECT ENGINEER S.GURI	FERRIER CPF DEEP CUT FEED					
1	ADDED ONE MORE BUILDING HEATER	05/10/13	HS	SG	CUST PO N/A		CATERPILLAR G3606LE					
0	ISSUED FOR CONSTRUCTION	05/07/13	HS	SG	APEGGA PERMIT No: P8651	OPER. CODE 198/298/490/511/591	ARIEL JGD/4-1 SWEET			WORK ORDER 31979-02		
REV	DESCRIPTION	DATE	BY	APR								

THE INFORMATION CONTAINED HEREIN IS THE CONFIDENTIAL PROPERTY OF ENERFLEX, LTD. AND IS NOT FOR PUBLICATION, AND NO PART THEREOF SHALL BE COPIED OR COMMUNICATED TO A THIRD PARTY WITHOUT AUTHORIZATION FROM ENERFLEX, LTD.