
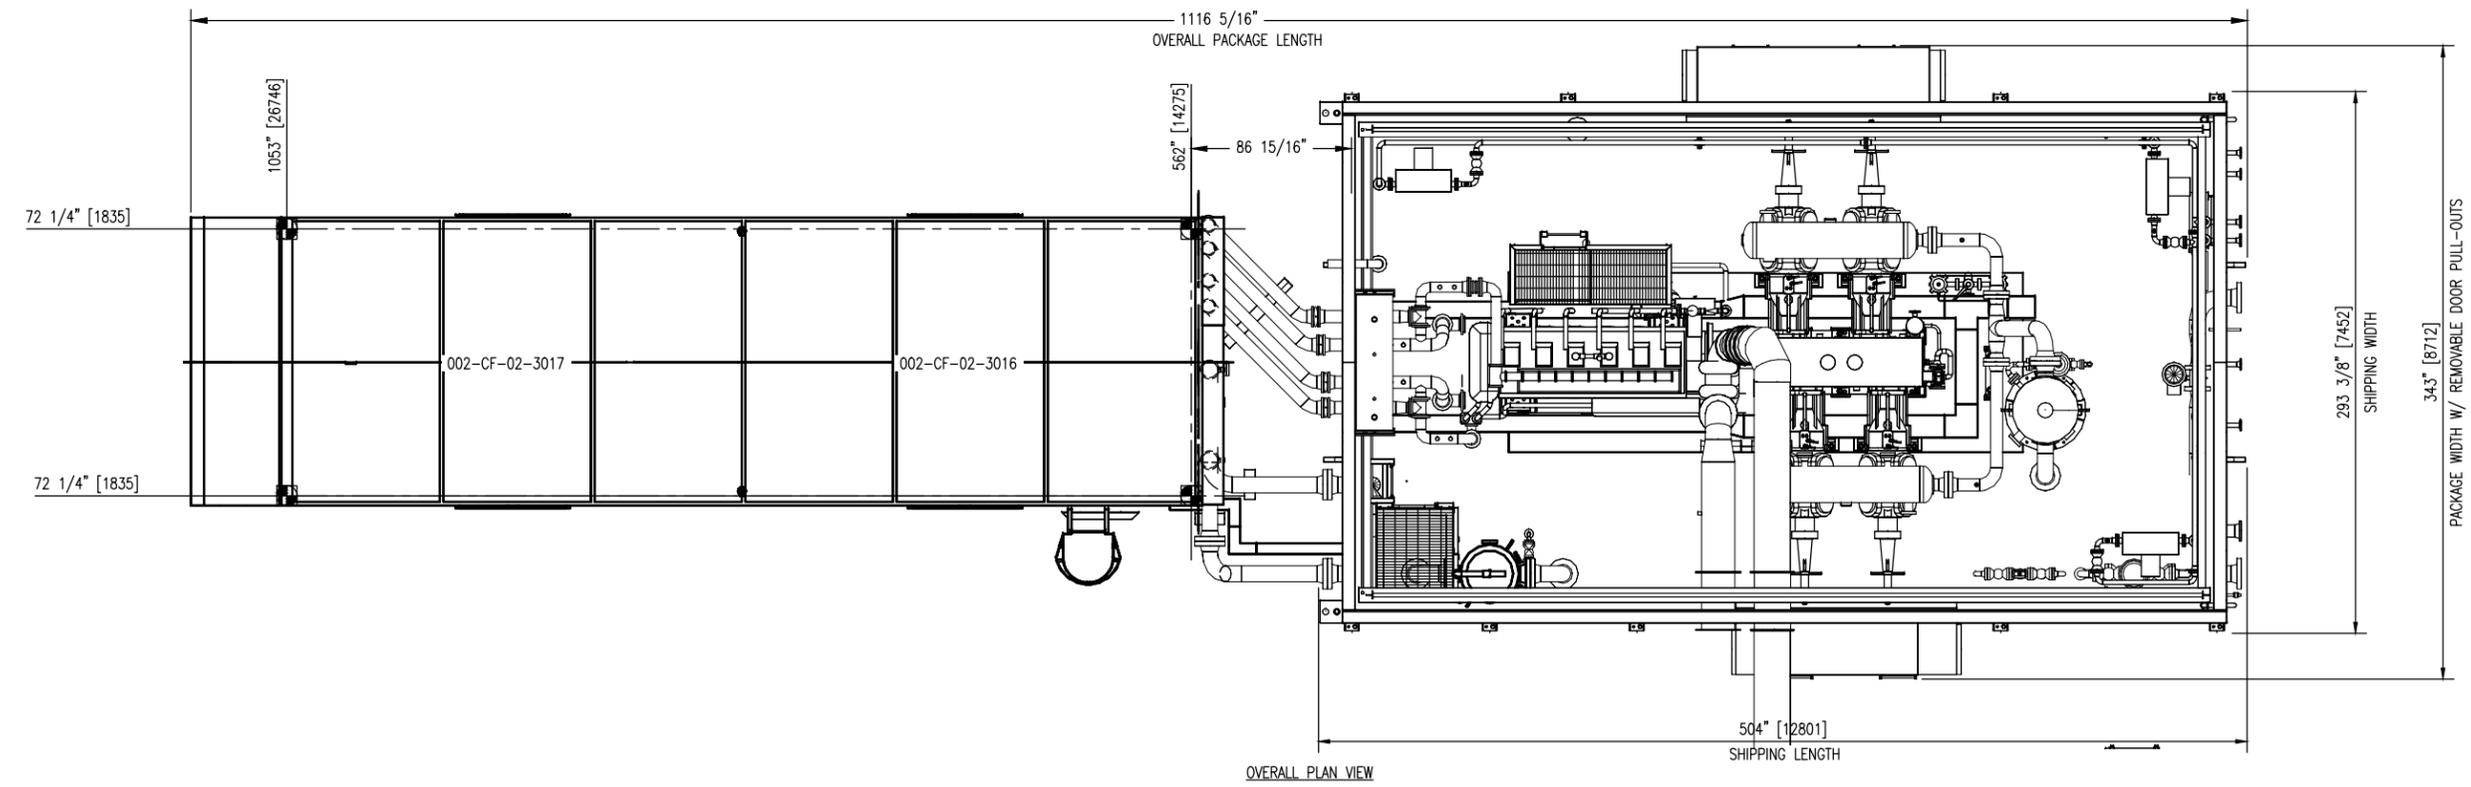
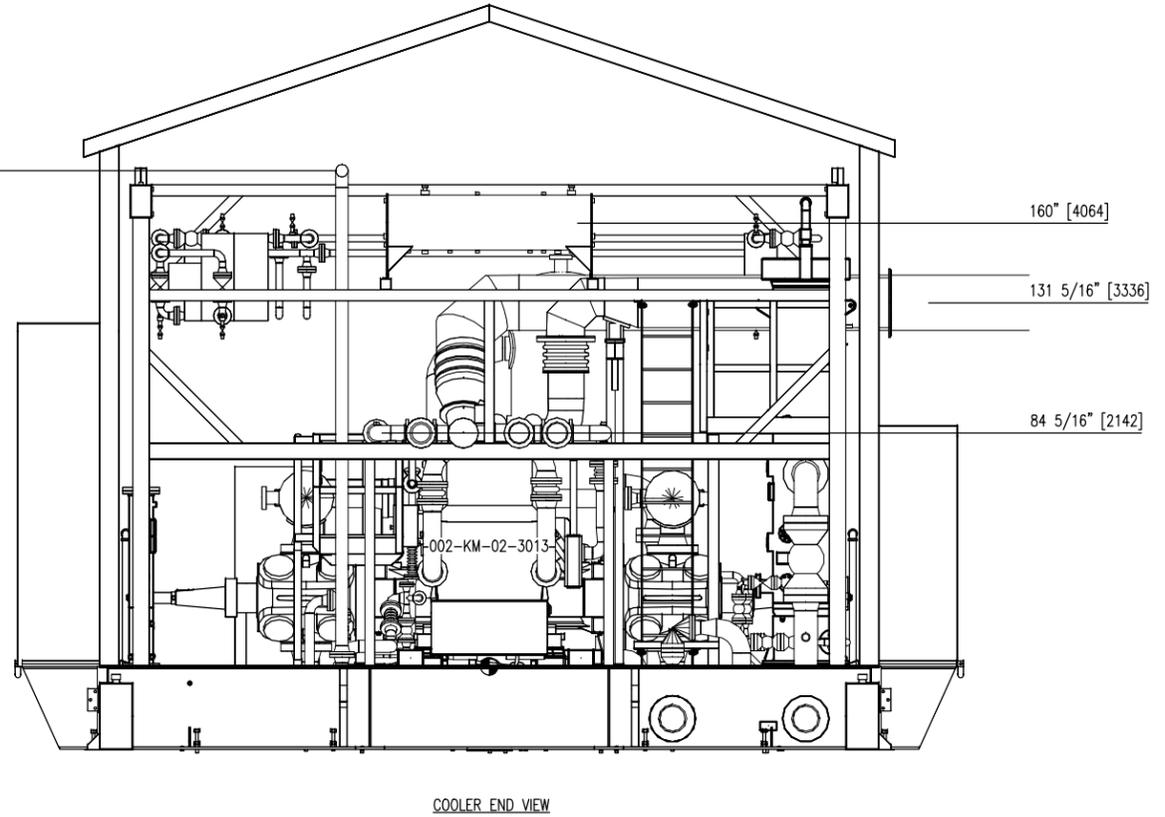


P:\30000 Projects\31979-02 Devon Canada - Ferrer - C3606E.dwg - Ferrer - C3606E.dwg - Sales Coe V. Drafting\31979-02-MODEL (AS BUILT).dwg
 PLOT DATE Feb 07, 2014, hsun

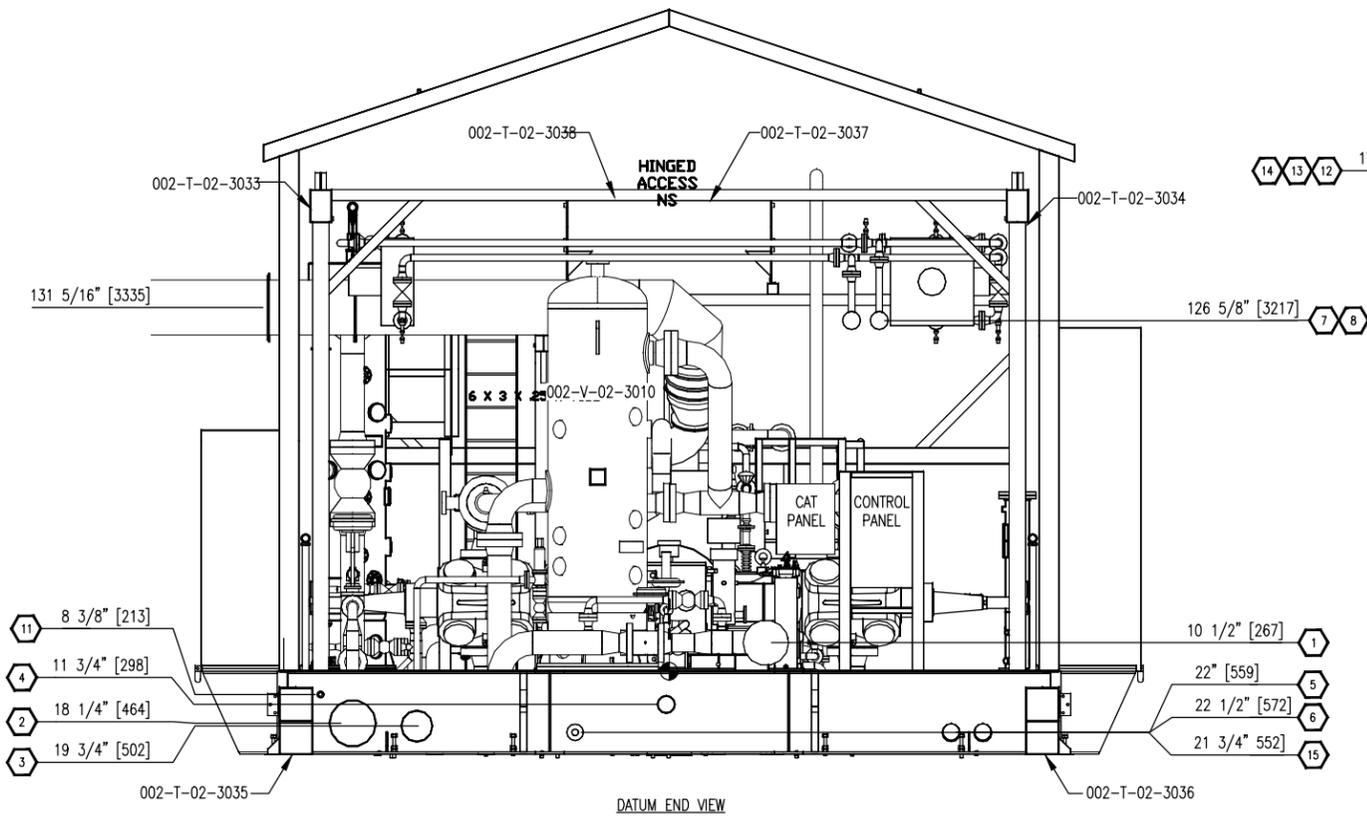

FINAL AS BUILT
 NAME H.SUN DATE FEB 06/14

	4 REVISED & AS BUILT 3 AS BUILT 2 REV'D WEIGHTS & NOZZLE SCHEDULE 1 ADDED ONE MORE BUILDING HEATER 0 ISSUED FOR CONSTRUCTION	FEB/06/14 SEP/03/13 MAY/23/13 05/10/13 05/07/13	HS HS CE HS HS	SG SG SG SG SG	DATE FEB 1/13 DRAWN BY C.EASTHOPE PROJECT MANAGER B.MINSHULL CHECKED BY G.TIWANA PROJECT ENGINEER S.GURI APPROVED BY S.GURI SCALE 1/2"=1'-0" CUST PO N/A	DEVON CANADA FERRIER CPF DEEP CUT FEED CATERPILLAR G3606LE ARIEL JGD/4-1 SWEET	ENERFLEX Calgary, Alberta, Canada	GENERAL ARRANGEMENT SECTION VIEW	DWG NO 31979-02-201 SHT 4 REV 4
	REV DESCRIPTION DATE BY APR	APEGGA PERMIT No: P8651 OPER. CODE 198/298/490/511/591 WORK ORDER 31979-02							

THE INFORMATION CONTAINED HEREIN IS THE CONFIDENTIAL PROPERTY OF ENERFLEX, LTD. AND IS NOT FOR PUBLICATION, AND NO PART THEREOF SHALL BE COPIED OR COMMUNICATED TO A THIRD PARTY WITHOUT AUTHORIZATION FROM ENERFLEX, LTD.