


SECTION "A-A"
1. SCALE 1/2"=1'-0"

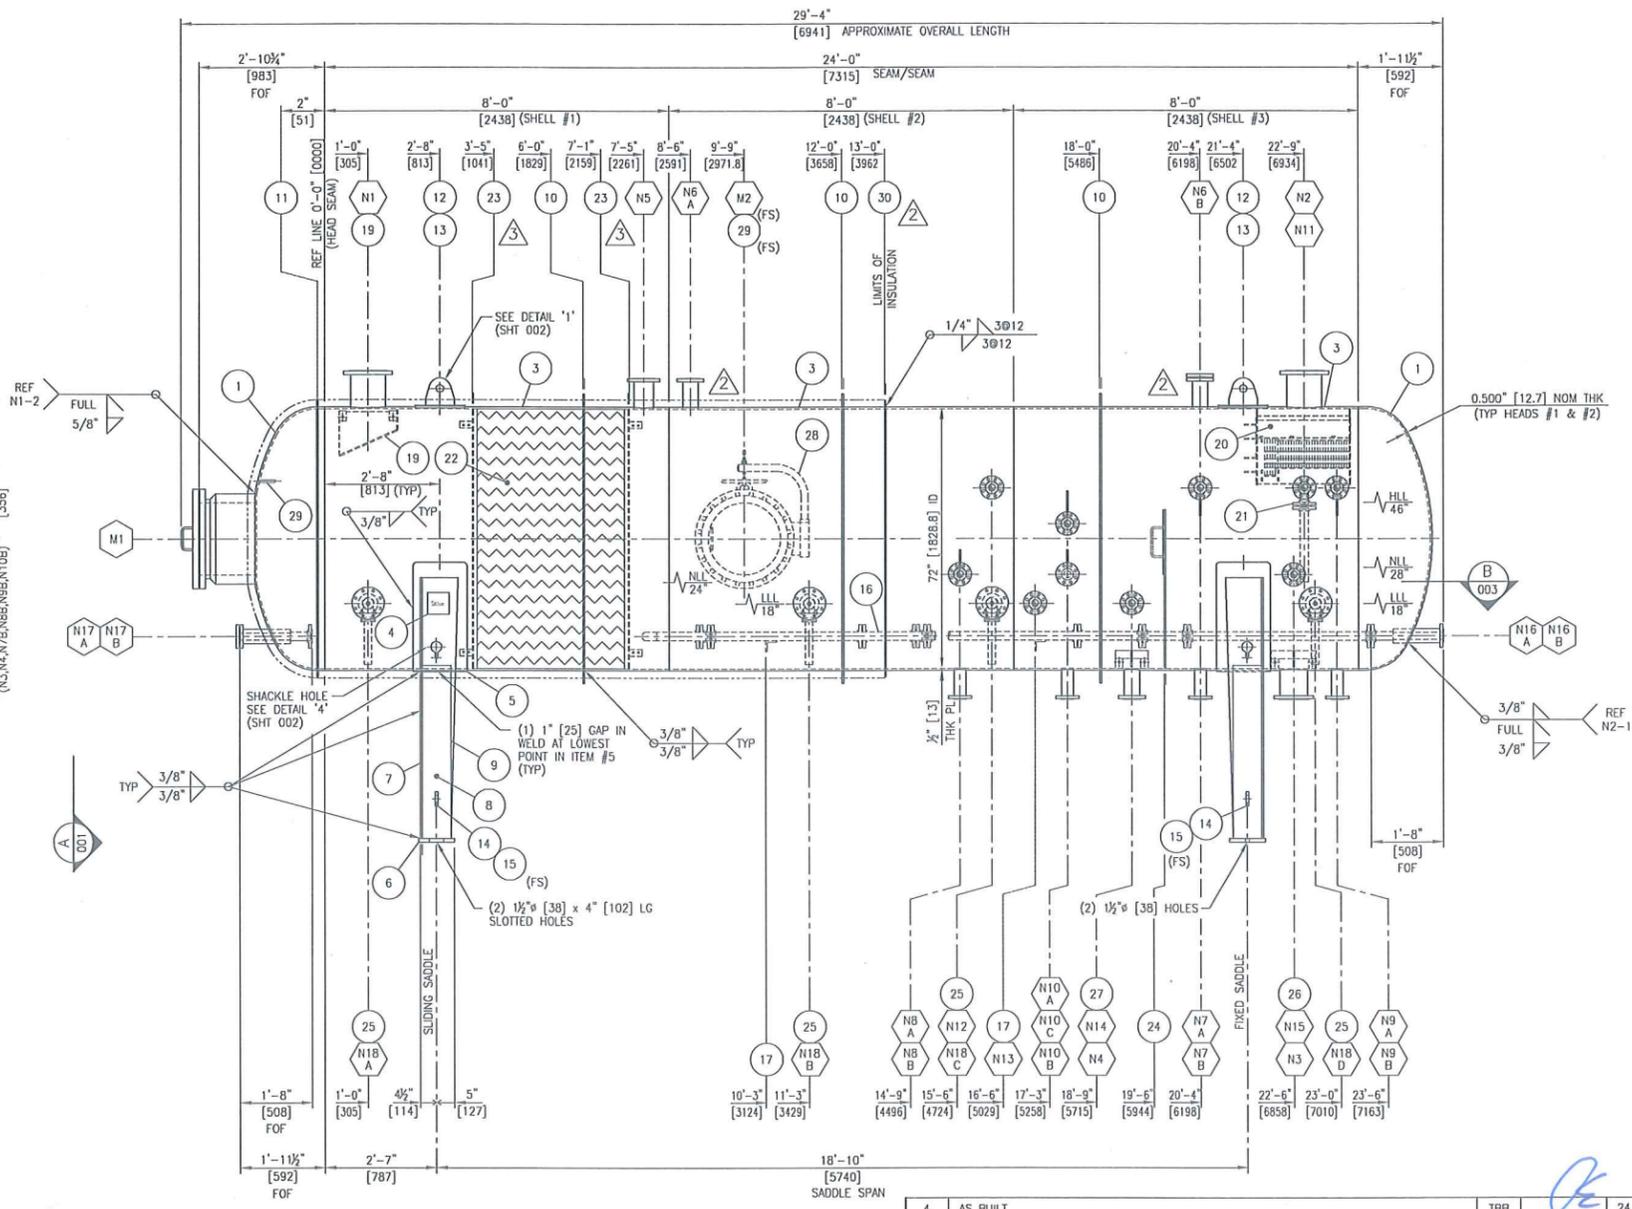

ELEVATION VIEW
1. SCALE: 1/2"=1'-0"

- NOTES**
- 1) SHOP NOTE: "FS" DENOTES FAR SIDE.
 - 2) REFER TO DWG# 5B1088-08-DR-20-002 FOR NOZZLE SCHEDULE AND BOM.
 - 3) REFER TO DWG# 5B1088-08-DR-20-003 FOR COIL DETAILS.
 - 4) REFER TO DWGS# 5B1088-08-DR-20-004 AND 005 FOR ADDITIONAL DETAILS.
 - 5) REFER TO DWG# 5B1088-08-DR-20-007 FOR VANE PACK DETAILS.
 - 6) REFER TO DWGS# 5B1088-08-DR-20-010 TO 015 FOR COALESCER PACK DETAILS.

REV. NO.	REVISION	BY	CHECKED	DATE
4	AS BUILT	TBB		24/09/13
3	REVISED COALESCER PACK SUPPORT (ITEM #23) LOCATIONS	TBB		10/04/13
2	NOZZLE N6 WAS 2" CL300, ADDED ITEM #30	TBB		26/03/13
1	ISSUED FOR CONSTRUCTION	TBB		13/03/13
0	ISSUED FOR LONG AND CIRC SEAM WELDING ONLY	TBB		22/02/13

5Blue
Process Equipment Inc.

5Blue Process Equipment Inc.
2303-8 St Nisku, Alberta, Canada - Phone 780.955.2040
www.5Blue.com

THIS DRAWING IS THE EXCLUSIVE PROPERTY OF 5BLUE PROCESS EQUIPMENT INC. AND MAY NOT BE COPIED OR COMMUNICATED TO A THIRD PARTY WITHOUT THE WRITTEN AUTHORIZATION OF 5BLUE PROCESS EQUIPMENT INC.

CUSTOMER	DEVON NEC CORPORATION		
CUSTOMER REF. NO.	RFP No. FC-1212496-M105	JOB NO.	5B1088-20
PROJECT	FERRIER CENTRAL OIL BATTERY - SEPARATION & TREATMENT LOCATION: LSD 11-02-039-08 W5M		
TITLE	FREE WATER KNOCK OUT VESSEL (001-V-01-1010) ELEVATION & ORIENTATION 72" ID x 24'-0" S/S x 150 PSIG @ 302'F 1829 mm ID x 7315 mm S/S x 1034 kPag @ 150°C		

DRWN	CHKD	APP'D	SCALE	DATE	DRAWING NUMBER	SHT
RR			1/4"=1'-0"	25/01/13	5B1088-08-DR-20-001	008