




FILE PATH: C:\Workspace\Drafting\Projects\D3400-3499\D3468\D3468.idw

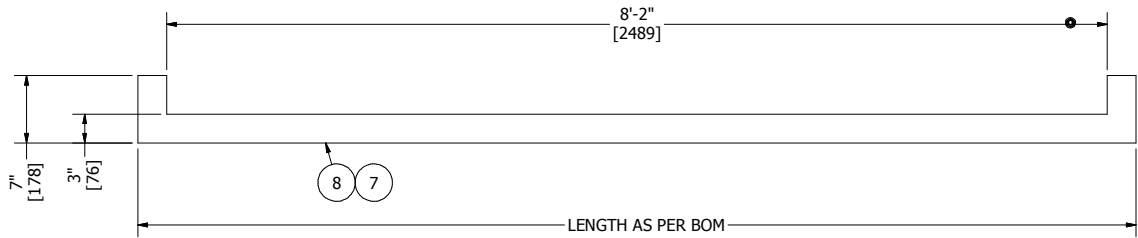


MISTEX PAD HANGER

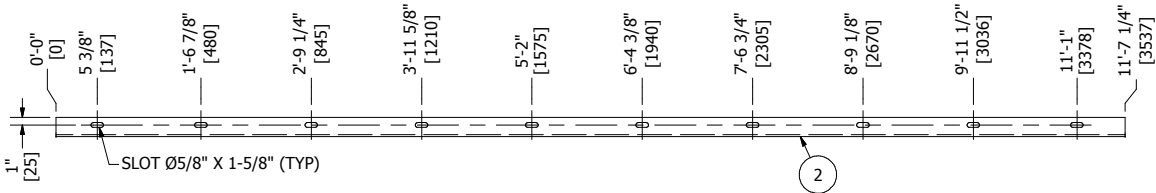


DETAIL COIL SUPPORT BEAM 1

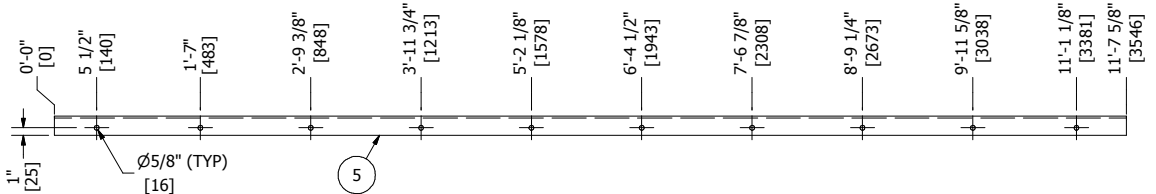






DETAIL ANGLE COIL CLAMP DOWN 2

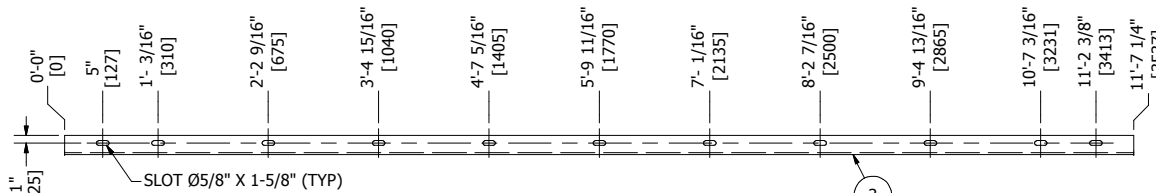


DETAIL COIL SUPPORT BEAM 2

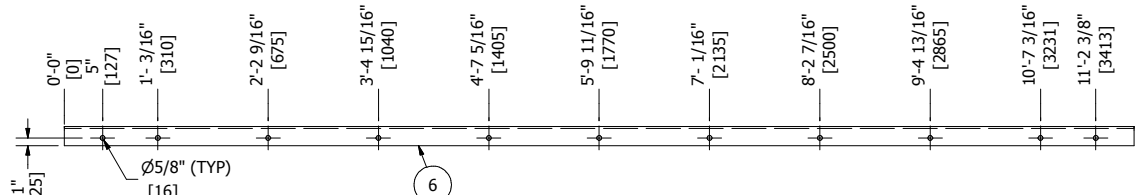


DETAIL ANGLE COIL CLAMP DOWN 2

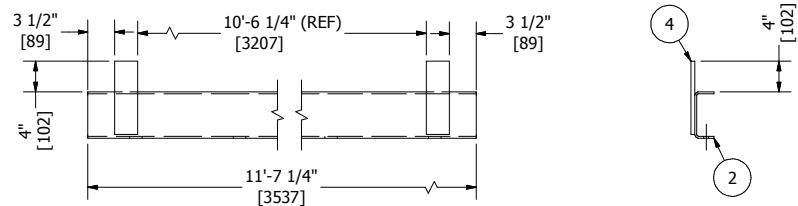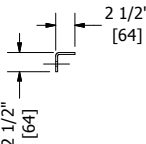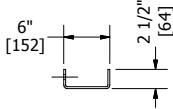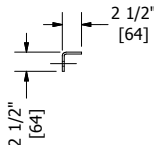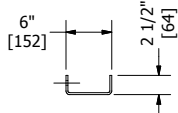


DETAIL HANGER ASSEMBLY 1

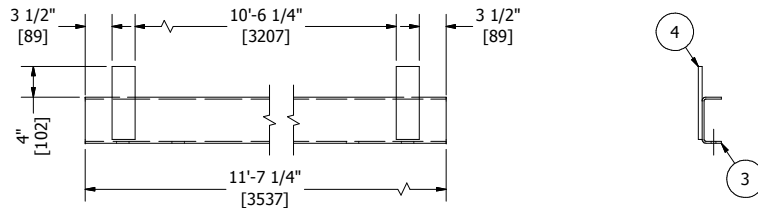

DETAIL HANGER ASSEMBLY 2

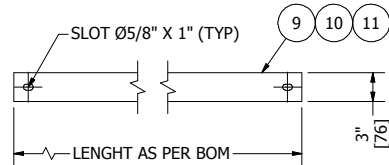

DETAIL MISTEX BAR
(QTY REQ: 2 OF EACH)

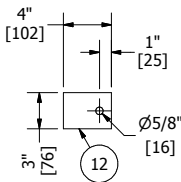

DETAIL MISTEX CLIP
(QTY REQ: 12X)



FEBRUARY 13, 2017

REV	DATE	DESCRIPTION	BY	ENG	PM	APP
0	9/8/2016	ISSUED FOR FABRICATION	AD	JAM	JDW	
1	02/10/2017	AS-BUILT	NHH	JAM	JDW	



BOX 6106
5815 37 Street
INNISFAIR, AB
CANADA
403-227-7799
1-888-227-4923
FAX 227-7796

WESTCOAST ENERGY INC.

174" OD x 16'-6" [4420mm x 5029mm] SULPHUR TAIL GAS COALESCER- TAG#: PV 17.43A
MISTEX PAD PARTS

QUOTE NUMBER: 07961	SALE ORDER: 004470	SIZE
PURCHASE ORDER: 2850038875	JOB ORDER:	D
LOCATION: CHETWYND, BC	D3468	
DATE: 03/15/2016	DRAWING NO.:	REV.
SHEET: 5 OF 8	D3468-204	1
CRN DWG: N/A		
CRN NUMBER: N/A		

This drawing is property of BILTON WELDING AND MANUFACTURING LTD and is lent to the recipient for their confidential use only. In consideration of the loan of this drawing, the recipient promises and agrees that it shall not be used in any way detrimental to the interests of BILTON WELDING AND MANUFACTURING LTD, that it shall be returned upon request, and shall not be reproduced, copied, lent, or otherwise disposed of, directly or indirectly, without the written consent of BILTON WELDING AND MANUFACTURING LTD.