


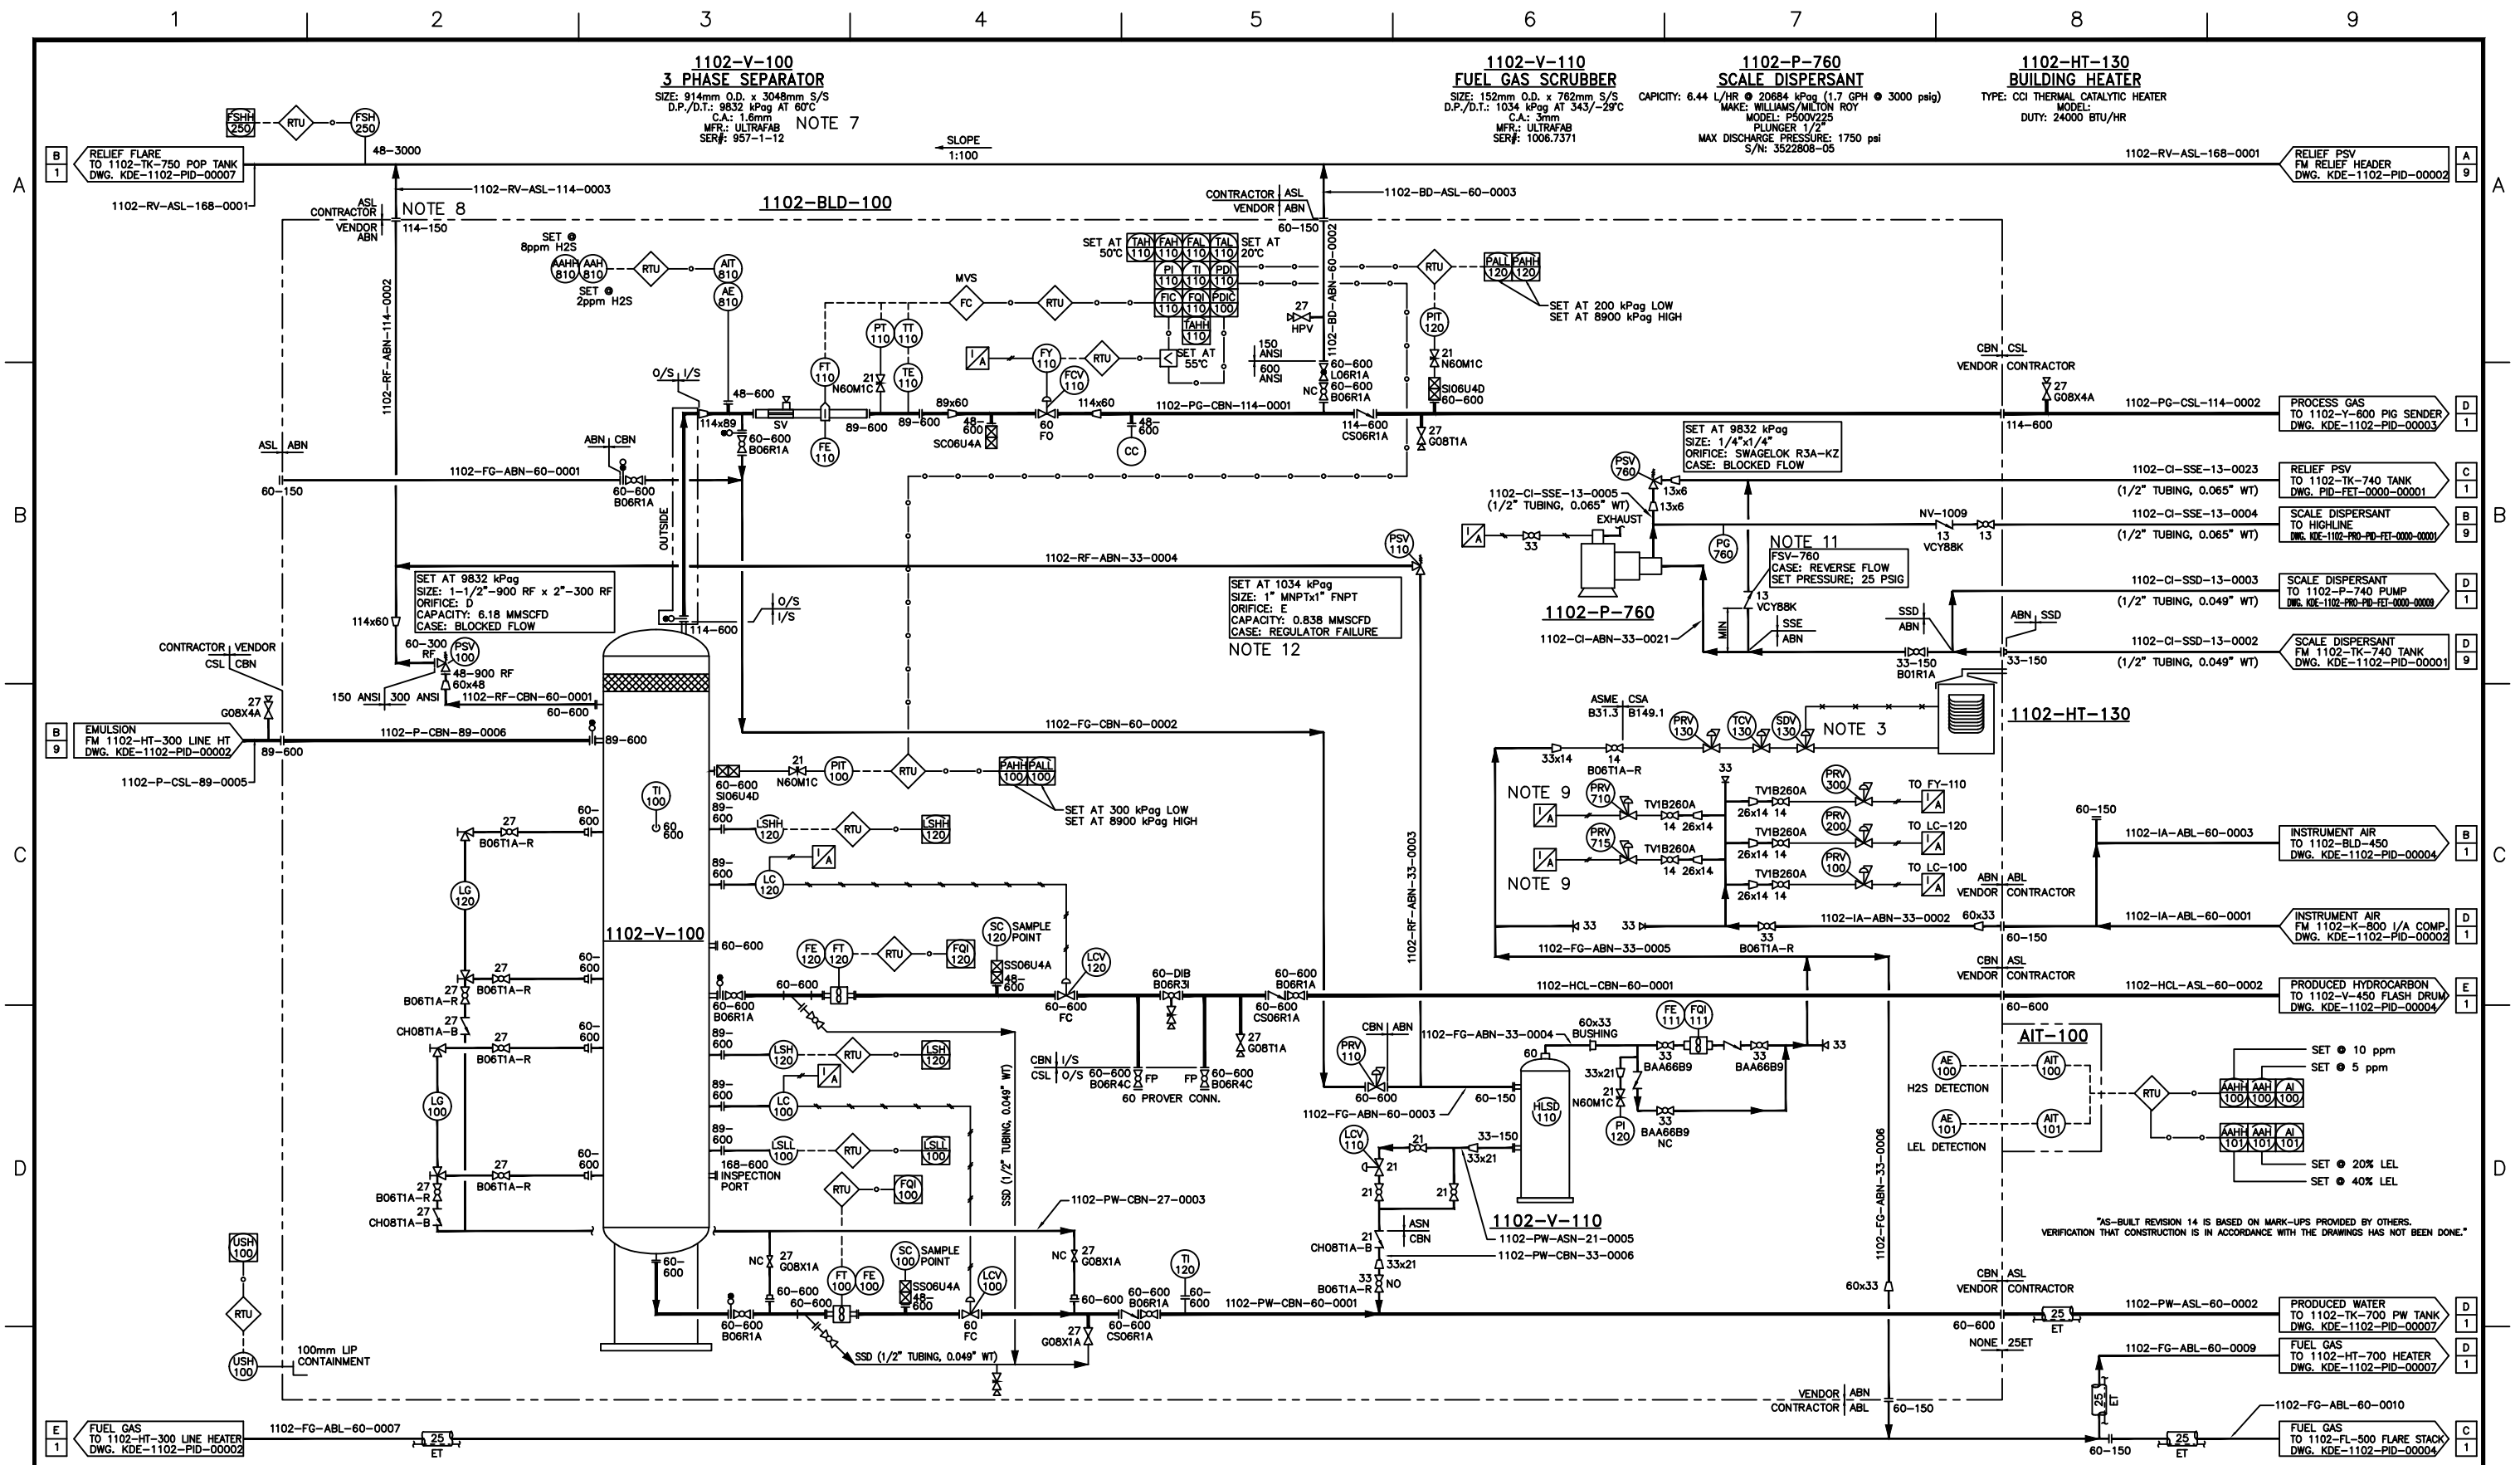

NOTES:

- ALL PIPING TO BE REGISTERED WITH ABGA.
- ALL INSTRUMENTATION TAGS PREFIXED WITH 1102.
- FUEL GAS PIPING MUST COMPLY WITH CSA B149.1-10 AND CSA B149.3-10. VALVES AS SHOWN MAY NOT BE TO CODE.
- DELETED.
- DELETED.
- PSV-120 DISCHARGE PIPING TO VENT TO ATMOSPHERE AT SAFE LOCATION.
- 1102-V-100 DESIGN PRESSURE DIFFERS FROM CSN RATING AS A RESULT OF STATIC PRESSURE OF LIQUID FULL VESSEL TO MAINTAIN CONSTANT FLANGE RATING OF 600# FOR ALL FLANGES.
- INSULATED AND HEAT TRACED DRAIN (ON OUTSIDE PIPING) TO BE INSTALLED ON PSV DISCHARGE PIPING IF LOW POINT/POCKET EXISTS (FIELD TO DETERMINE).
- EXISTING INSTRUMENT TAG AND I/A USER TO BE FIELD VERIFIED.
- REVISION 11 AS-FOUND CHANGES PER FIELD VERIFICATION WALKDOWN FOR PHA REVALIDATION.
- CH8 SERIES SWAGelok POPPET CHECK VALVE WITH FIXED CRACKING PRESSURE OF 25 PSIG TO PROTECT 150# SUCTION PIPING FROM REVERSE FLOW.

REVISIONS

REV. NO.	DESCRIPTION
13	ISSUED FOR CONSTRUCTION (WORLEY MOC # 950535)
12	ISSUED FOR AS-BUILT (PHA REVALIDATION)
11	ISSUED FOR CONSTRUCTION (PHA REVALIDATION)
10	ISSUED FOR AS-BUILT (STT #110616828, MOC #662754)
9	ISSUED FOR CONSTRUCTION (STT #110616828, MOC #662754)
15	ISSUED FOR AS-BUILT (AS FOUND, PSV-110 CORRECTIONS)
14	ISSUED FOR AS-BUILT (WORLEY MOC # 950535)

SCALE

NTS

Chevron

KAYBOB DUVERNAY

08-15-062-18 W5M

WELLSITE

INLET SEPARATOR

PROCESS PID

15

KDE-1102-PRO-PID-FET-0000-00005/KDA-1102-PRO-PID-FET-0000-00005/KDU-TWCK-W500-PRO-PID-FET-0000-00005