SECTION1-1

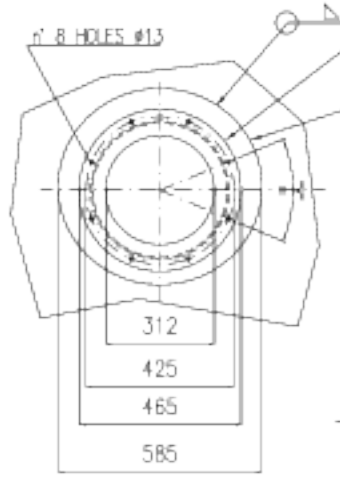

SECTION L-L

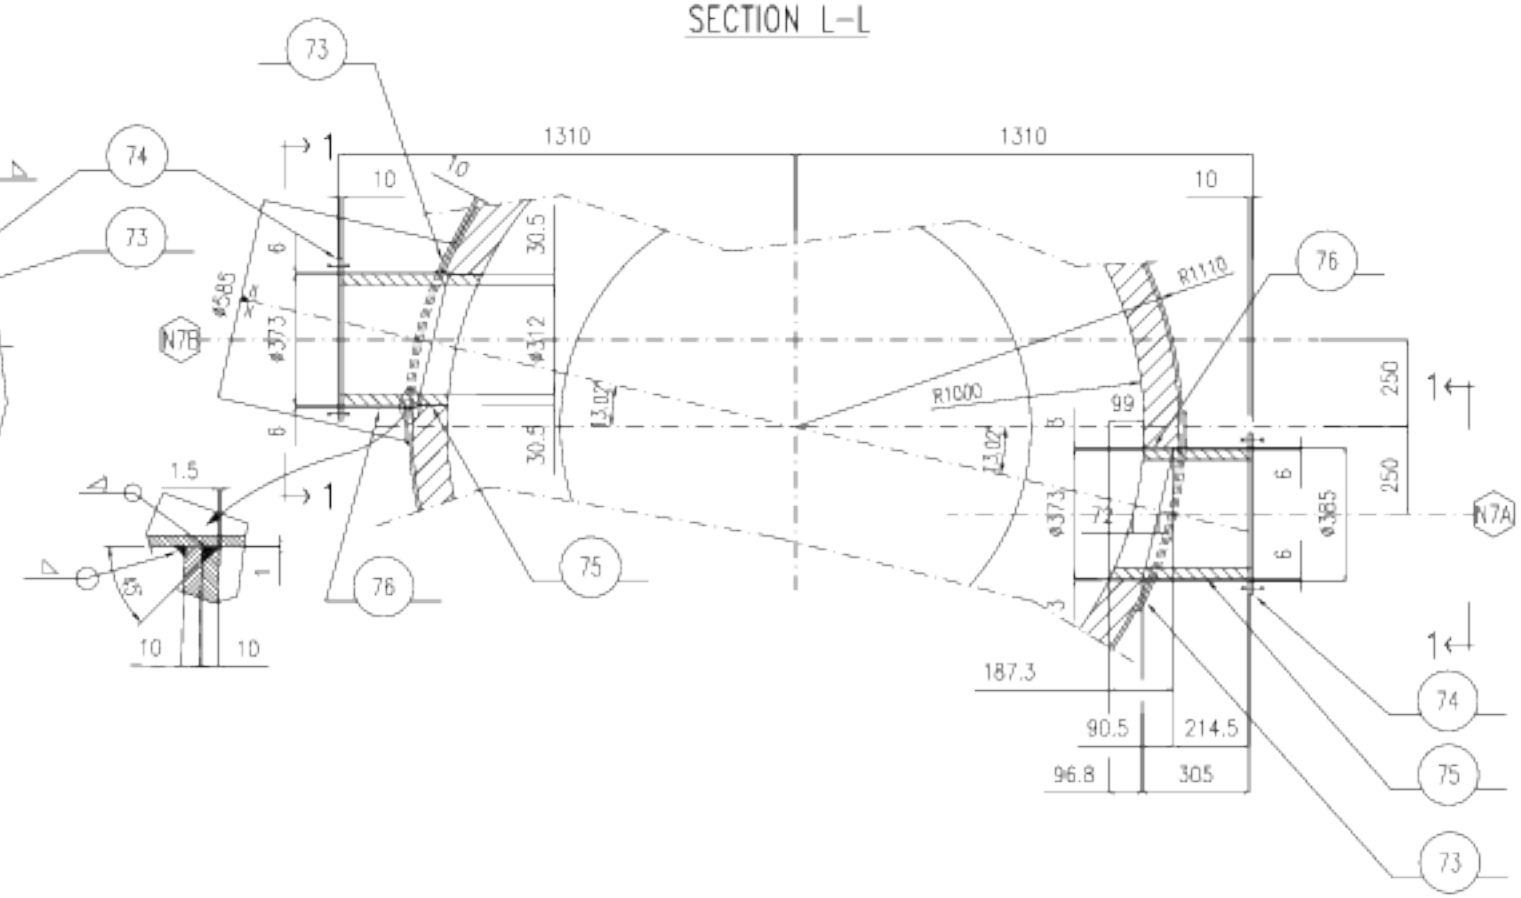

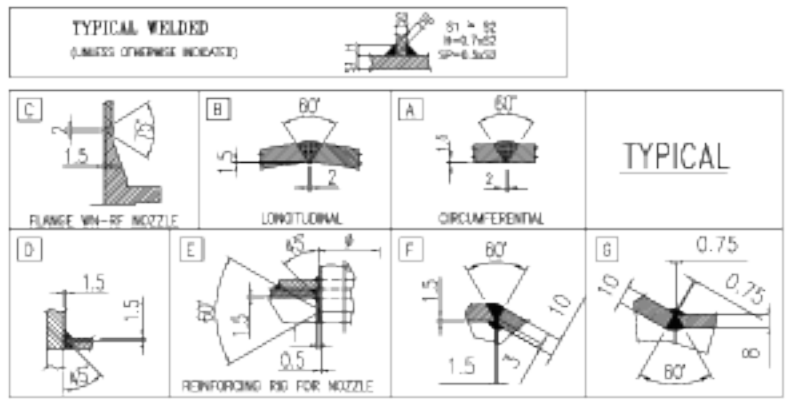

FOR ASSEMBLY SEE DWG.165-102

1	21.12.2007	AS BUILT	E.M.	S.B.	E.G.
0	16.06.2007	ISSUED FOR APPROVAL	E.M.	S.B.	E.G.
REV. REV.	DATA DATE	DESCRIZIONE DESCRIPTION	ESEGUITO PREPARED	CONTROLLATO CHECKED	APPROVATO APPROVED

CLIENTE CLIENT	TALISMAN ENERGY Inc.	IMPIANTO PLANT	TALISMAN TEEPEE GAS
ORDINE ORDER	GP301581 Rev.1	LOCALITA' LOCALITY	CANADA

HAMWORTHY COMBUSTION

HAMWORTHY COMBUSTION ENGINEERING SRL

VIA CESARE II - 20090 LOCATE MILAN - ITALY TEL. 039-9459949 FAX 039-2489008 E MAIL info@hamworthy-combustion.it

SCALA SCALE	1:5	DESCRIZIONE DESCRIPTION: DETAILS REPLACEMENT OF EXISTING INCINERATOR ITEM: FF-25.01
DATA DATE	23.04.2007	

DOC. REF. ITT.1565

N. 1565-111

ESEGUITO PREPARED	E.M.
CONTROLLATO CHECKED	S.B.
APPROVATO APPROVED	E.G.

QUESTO DISEGNO NON PUO' ESSERE COPIATO, RIPRODOTTO O MESSO A TERZI SENZA PREVENTIVA AUTORIZZAZIONE SCRITTA

THIS DRAWING SHALL NOT BE COPIED, REPRODUCED, LENT OR DISCLOSED WITHOUT OUR WRITTEN CONSENT.