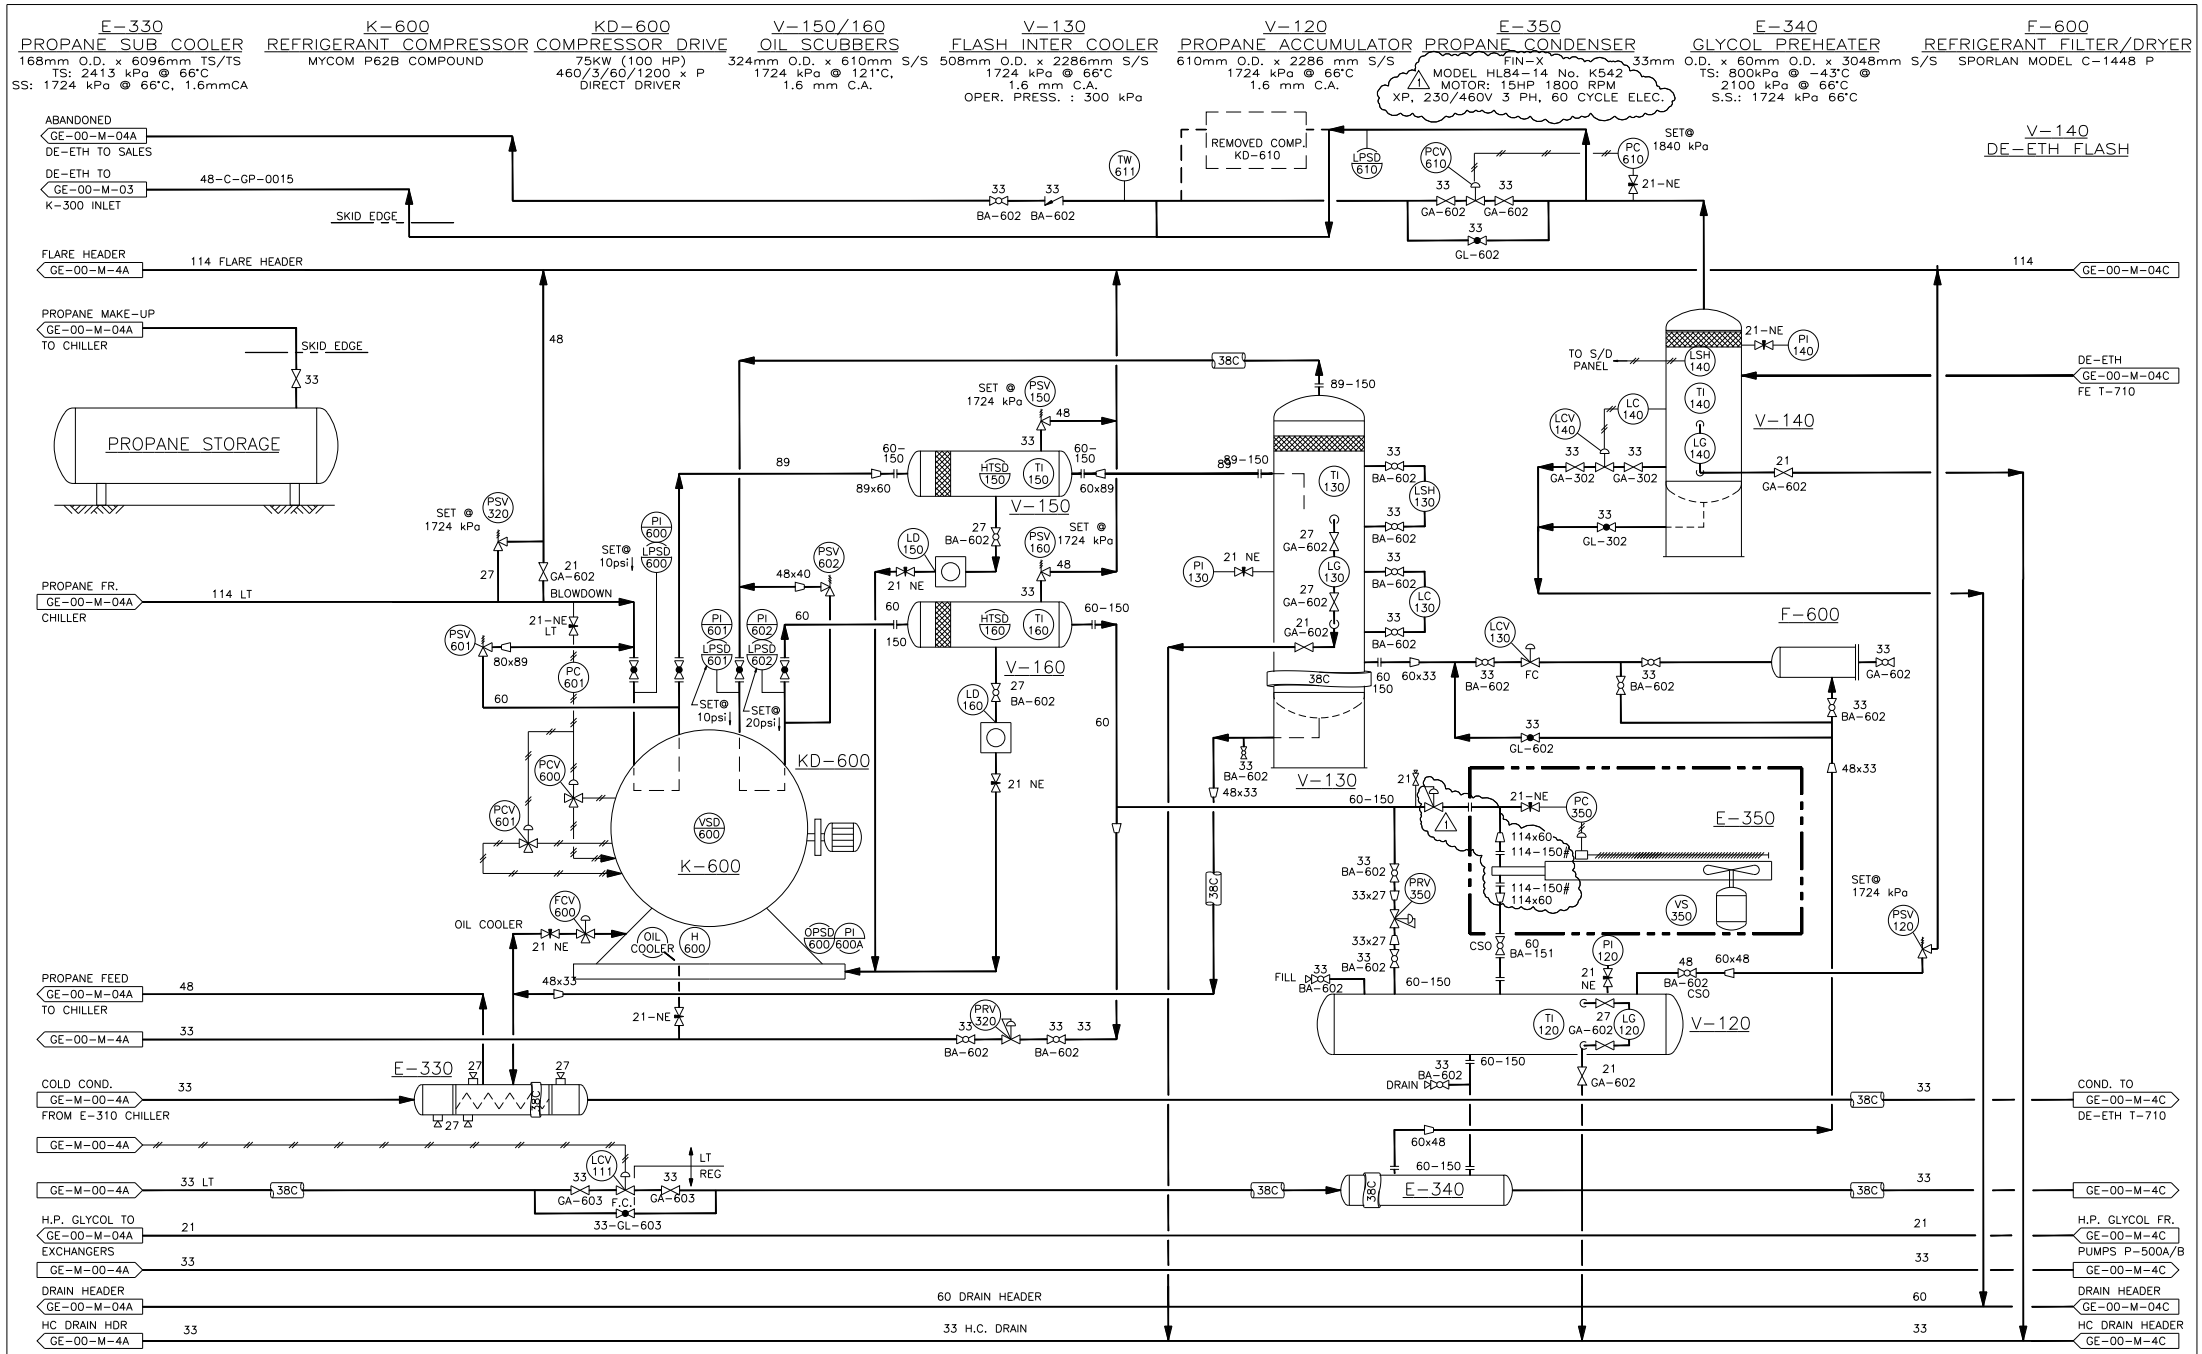

NUMBER	REFERENCE DRAWINGS	NO	REVISION DESCRIPTION	BY	DATE	CHD	APPD	ENGINEERS & PERMIT STAMPS
E-MFS-85348-100	PROPAK SYSTEM Ltd	0	REDRAWN ON AutoCAD	J.W.	98.12.19	LJC	D.M.	
SH 2of3		A	ISSUED FOR APPROVAL	CDC	99.01.11	D.M.	D.M.	
		B	ISSUED FOR CONSTRUCTION	CDC	99.01.21	D.M.	D.M.	
		C	ADDED VENT/PER CUSTOMER REQUEST	LJC	99.02.08	LJC	D.M.	
		D	AS BUILT (AS PER ENGINEER)	CDC	99.03.15	D.M.	D.M.	
		1	AS BUILT PROPANE CONDENSOR	LJC	00.06.28			

98180

PROTO: FS-8080

Tundra

TUNDRA ENGINEERING LTD.
CALGARY, ALBERTA

RAX

RIO ALTO EXPLORATION LTD.

A1-GE-00-M-04B

GEORGE
6-32-82-5-W6M
REFRIGERATION PLANT
MECHANICAL FLOW DIAGRAM

	DRAWN	CHECKED	APPROVED	SCALE	DRAWING NUMBER	REV
BY	J. Wiechecki	L.Corbett	D.Moore	N.T.S.	D-GE00632-320-07	1
DATE	98.12.19	98.12.19	98.12.21			