T-4-100	V-4-200	V-4-400	H-4-300	F-4-400	F-4-500	E-4-600	P-4-600	UH-4-600
GLYCOL ABSORBER	FUEL GAS SCRUBBER	GLYCOL FLASH DRUM	GLYCOL REBOILER	GLYCOL FILTER	GLYCOL FILTER	GLYCOL EXCHANGER	GLYCOL PUMP	BUILDING HEATER
24" OD x 28'-0" S/S x 1440 PSIG x -20/130°F, 1/8" C.A. 100% X-RAY, STRESS RELIEVED	12 3/4" OD x 6'-0" S/S x 275# x -20/130°F, 1/16" C.A. STRESS RELIEVED	20" OD x 5'-0" S/S x 150# x -20/130°F, 1/8" C.A. STRESS RELIEVED	24" OD x 8'-6" LG x 300,000 BTU/HR, 316SS PACKING IN STILL AND STRIPPING COLUMN	CUNO 1B2 c/w CHARCOAL FILTER	PEACOCK 3000L-2 GLYCOL FILTER, 3000 PSI @ 250°F c/w 1-25 MICRON PARTICULATE FILTER	(4)-PASSES TRANE FINTUBE, 1 1/4" OD x 10'-0" LONG	KIMRAY 21015 PV c/w VITON TRIM	30,000 BTU/HR CATADYNE HEATER c/w REGULATOR, THERMOSTAT, PROTECTION GRILL, 12 VOLT START-UP, SSOV, VENT HOOD

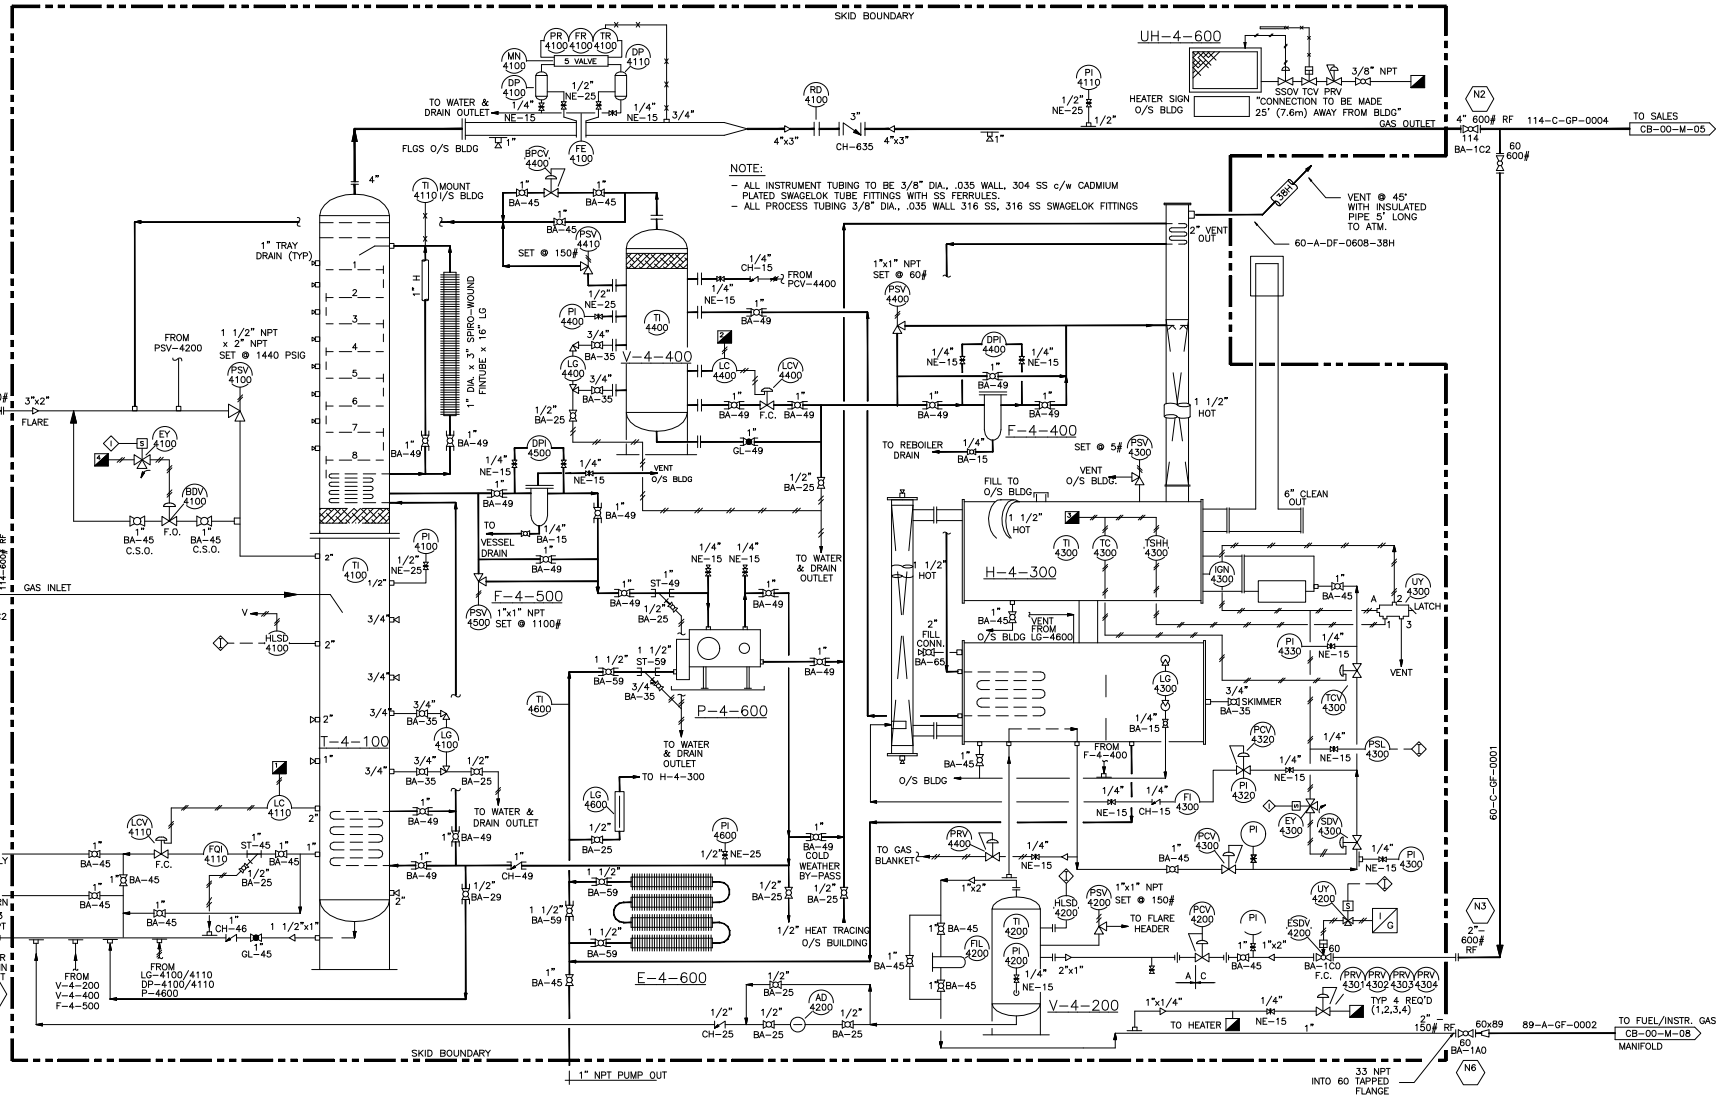

99035 ⚠

A1-CB-00-M-04

NUMBER	REFERENCE DRAWINGS	NO	REVISION DESCRIPTION	BY	DATE	CHD	APPD
C-847-C	24" OD x 1440 PSIG DEHYDRATION UNIT (SOUR)	A	ISSUED FOR APPROVAL – EQUIPMENT & PIPERACK	JW	99.09.21	P.W.	D.M.
	(RUSHTON – VENDOR DWG REV. 2)		RELOCATED FROM PEMBINA COMPR. STATION ⊗6-31				
		0	ISSUED FOR CONSTRUCTION	P.W.	99.11.02	D.M.	D.M.
		1	AS BUILT	J.W.	00.05.08		

ENGINEERS & PERMIT STAMPS

Tundra

TUNDRA ENGINEERING LTD. CALGARY ALBERTA

	DRAWN	CHECKED	APPROVED
BY	J.Wiechecki	P.Wiechecki	D.Maxwell
DATE	99.09.21	99.09.21	99.09.21

BPC Berkley Petroleum Corp.

Berkley Petroleum Corp.

CRANBERRY
LSD 8-13-97-4 W6M
24" OD x 1440 PSIG DEHYDRATION UNIT (SOUR)
MECHANICAL FLOW DIAGRAM

SCALE	DRAWING NUMBER	REV
N.T.S.	CRN0813-220-0004	1

DISK NO H:\JRAP\BPC\DRAWS\UDY\P&ID
CHD DWG NO (R13C4c) CB00M04

PROTO: BPC-A1_REV1