THE DESIGN IT COVERS ARE CONFIDENTIAL AND THE PROPERTY OF PROPAK SYSTEMS LTD., AND SHALL NOT BE DISCLOSED TO OTHERS OR REPRODUCED IN ANY MANNER OR USED FOR ANY PURPOSE WHATSOEVER EXCEPT BY WRITTEN CONSENT OF PROPAK.

F-220
FUEL GAS FILTER
HEAD LINE 385-AP-70C-1-1/2"
1724 kPag @ 93°C
c/w 70-C FILTER ELEMENT

P-226/M226
ENGINE PRELUBE PUMP
GAS DRIVEN MOTOR
c/w ENGINE

KD-200
COMPRESSOR DRIVER
WAUKESHA 5774 LT
1250 BHP @ 1200 RPM
932 kW_b @ 1200 RPM

STR-227
ENGINE STARTER
TDI TURBO TWIN
M/N: T112-60001-B1R
30.875 sm^3/min @ 827 kPag

ES-225
SILEX SILENCER
MODEL: JAT-12 RESIDENTAL GRADE
305mm-125# FF INLET x 305-125# FF OUTLET

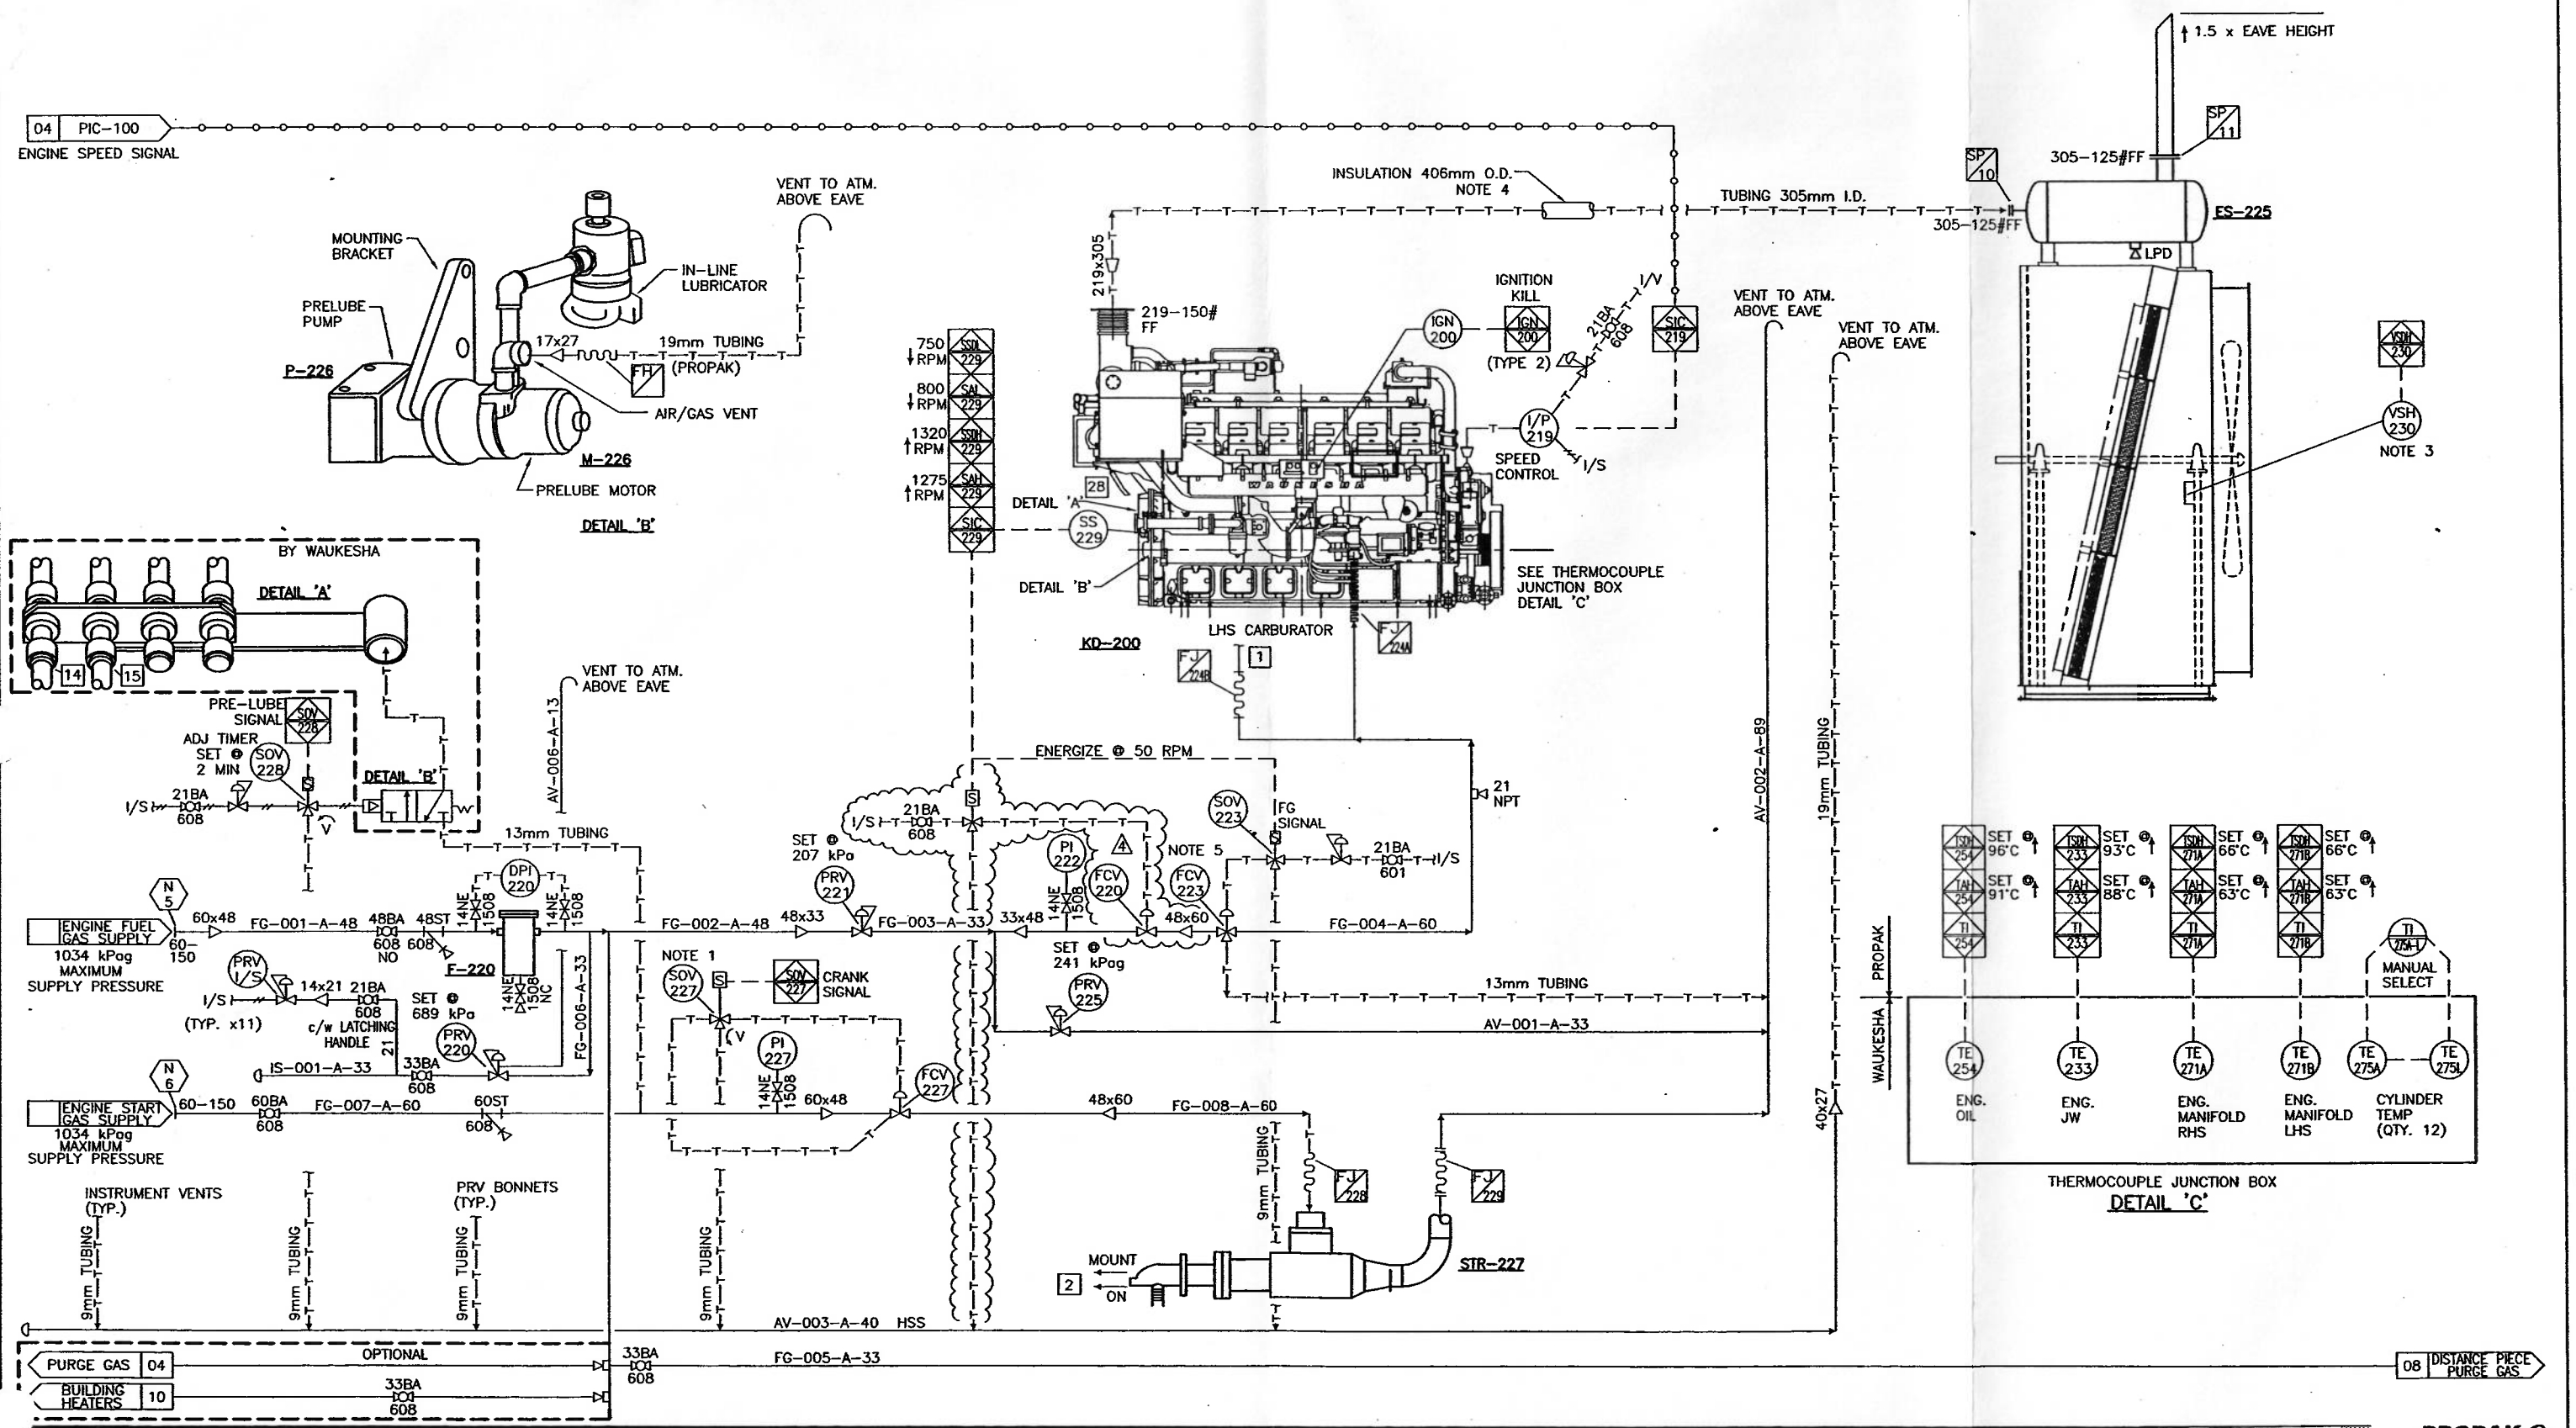

No.	REVISION	BY	DATE	CKD	ENG
4	SOLD TO CANADIAN FOREST OIL LTD.	P. YU	05/08/25	SM	
3	AS BUILT	H. CA	04/02/26	GW	GW
2	GENERAL REVISIONS	P. FEN	03/05/14	GW	GW
1	ISSUED FOR CONSTRUCTION	H. CA	03/05/09	GW	GW

GENERAL NOTES

1. HIGH PRESSURE SOV.
2. ENGINE CONNECTION INDEX SEE MFS-01460-100-03.
3. LOCATE VSH CLOSE TO FAN SHAFT ON BEARING SUPPORT.
4. INSULATE TO BUILDING WALL ONLY.
5. LOCATE FCV-223 AS CLOSE TO ENGINE AS POSSIBLE.

DATE: 2005/08/25 11:56 AM J:\JOBS01\01460\20-DRAWINGS\FLW\MFS-01460-100-05.DWG pyu

APPROVED		DRAWN	
MECH./STRUCT.		BY	PSC
DATE		DATE	MAY 09/03
ELECTRICAL		CHECKED	
DATE		BY	G. WICK
PROJECT	G. WICK	DATE	MAY 09/03
DATE	MAY 09/03		
		SCALE	

CANADIAN FOREST OIL LTD.

W1250-JGK4-3 COMPRESSOR
ENGINE FUEL & START GAS SYSTEM
MECHANICAL FLOWSHEET

DWG. No.: D-MFS-01460-100 SHT. 5 OF – REV. 4

PROPAK
440 East Lake Road,
Postal Bag #2
Airdrie, Alberta
Canada T4B 2C3